


Glen ST

St. 507
Pl.
Ave. No.

Name of Owner

Labor and Mat'l. Report 11/2/2009

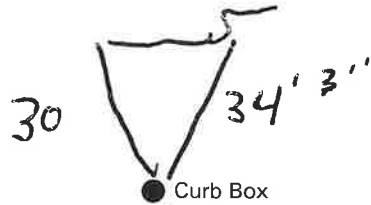

12" Main

Elev. of Main at tap 5' 6"

Gate at ●

● Gate at

TAX ID # 302.16-2-11

● Curb Box

sewer next to water line

LABOR AND MATERIALS

3/4	Copper Lead	Connection	\$
	Curb } Cock	in.	\$
	Valve } T.S. & V.		
	Service box	{ Short 3-1/2 x 4-1/2	\$
	Old returned	{ Long 4-1/2 x 5-1/2	\$
12	Ft. in. Copper	Pipe at	\$
		G.I. C.I.	
	Nipples	in. at	\$
	Bushings	to in. at	\$
	Red'g		
	Inc'g		
	Union	in. at	\$
	Meter	in. at	\$
			\$
	Compound Joints	at	\$
	Maintenance Foreman		\$
	Hrs. Water Maint. Man - 1	at	\$
	Hrs. Water Maint. Man - 2	at	\$
	Hrs. Garage Foreman	at	\$
	Hrs. Labor	at	\$
	Hrs. Compressor	at	\$
			\$
	Trucking		\$
	Pav't Patch		\$
	DAN G CHAD		\$
	Tony CURT		\$
	John Cortez		\$
			\$

LABOR AND MATERIALS

Copper } Connection		\$
Lead } T.S. & V.		\$
Curb } Cock Valve	in.	\$
		\$
1 Service box } Short 3 1/2 x 4 1/2		\$
Old returned } Long 4 1/2 x 5 1/2		
	Buff or Rdway	
Ft. in. } Copper	Pipe at	\$
	G. I.	\$
	C. I.	\$
Nipples	in. at	\$
Bushings	to in. at	\$
Red'g } Coupl'gs.	to in. at	\$
Inc'g }		\$
Union	in. at	\$
Meter	in. at	\$
Lead Joints	at	\$
Compound Joints	at	\$
Maintenance Foreman		\$
Hrs. Water Maint. Man-1	at	\$
Hrs. Water Maint. Man-2	at	\$
Hrs. Garage Foreman	at	\$
Hrs. Labor	at	\$
Hrs. Compressor	at	\$
Compensation Ins. at \$	per C	\$
Trucking		\$
Pav't Patch		\$
Measured 112		\$
10-15-68 by		\$
Fasmer & Parokan		\$
O'head		\$
		\$

St. _____
 PL. _____
 Ave. No. 507

Glen

Name of Owner _____

Measured 112
 Labor and Mat'l. Report Oct. 15 1968

30' 5"
 34' 8"
 ● Curb Box
 Buried 6"
 Bussalo
 12" Main
 Elev. of Main at tap 5' 6"
 Gate at ● Gate at ●
 on South Side of Piece of IRON
 ● Curb Box

New
2009

LSM-5C-6-1-67