


LABOR AND MATERIALS

Copper	} Connection		\$	
Lead				
Curb	} Cock	} in.	\$	
				} Valve
Service box	} Short 3 1/2 x 4 1/2	}	\$	
Old returned				Long 4 1/2 x 5 1/2
				Buff or Rdway
38 Ft. 3/4 in.	} Copper	} Pipe at	\$	
				C.I.
Nipples	in. at		\$	
Bushings	to in. at		\$	
Red'g	} Coupl'gs	to in. at	\$	
Inc'g				
Union	in. at		\$	
Meter	in. at		\$	
Lead Joints	at		\$	
Compound Joints	at		\$	
Maintenance Foreman	at		\$	
Hrs. Water Maint. Man-1	at		\$	
Hrs. Water Maint. Man-2	at		\$	
Hrs. Garage Foreman	at		\$	
Hrs. Labor-	at		\$	
Hrs. Compressor	at		\$	
Compensation Ins. at \$	per C		\$	
Trucking			\$	
Pav't Patch			\$	
			\$	
			\$	
			\$	
O'head			\$	
			\$	

GLEN St. Pl. Ave. No. 508

Name of Owner
RENEWAL TAP

Labor and Mat'l. Report SEPT. 3 1982

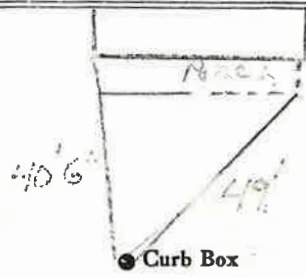

Main Elev. of Main at tap
Gate at • Gate at •

• Curb Box
renewal tap

40' 6" 49'
Renewal tap