

Labor and Materials

1	Copper Lead	Connection		\$ 1.23
1	Curb	Cock Valve T-S. & V.	3/4 in	\$ 1.68
1	Service Box Old returned	Short 3 1/2 x 4 1/2 Long 4 1/2 x 5 1/2 Buff. or Rdway		\$ 1.75
12	Ft. 3/4 in.	Copper Galv-Iron Cast-Iron	Pipe at 15	\$ 1.90
	Nipples	in. at		\$
	Bushings	to in. at		\$
	Red'g Inc'g	Conplings to in. at		\$
	Union	in. at		\$
	Meter	in. at		\$
	Lead Joints	at		\$
	Leadite Joints	at		\$
	Hrs. Foreman	at		\$
5	Hrs. Chauffeur	at 6 1/2 hr		\$ 3.13
4	Hrs. Tapper	at		\$ 2.50
8	Hrs. Labor	at 45		\$ 3.60
	Hrs. Labor	at		\$
2	Hrs. Compressor	at 8 1/2 hr		\$ 1.75
	Compensation Ins.			\$ 28
	Trucking			\$ 1.00
	Builders Use of Water			\$
	Tape Measure			\$
	Patch			\$ 9.00
				\$
				\$ 27.72

2-4-1938


Glen

St. 513
Pt.
Ave. No. 311

Name of Owner

Fassett

Labor and Mat'l. Report 5-20-38 19

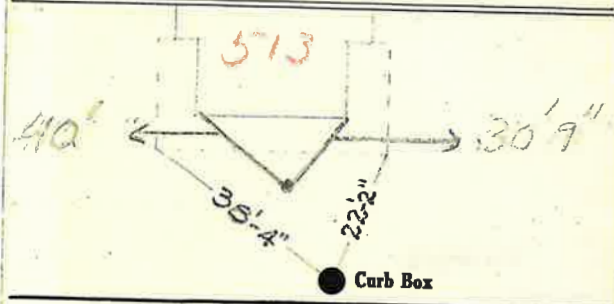

TAX ID # 302.16-2-7

12" Main Elev. of Main at tap 5'

Gate at ● Gate at ●

● Curb Box

old sketch of curb box