


LABOR AND MATERIALS

1	Copper Lead	Connection	$\frac{3}{4}$	\$ 2.60
1	Curb	Cock Valve T.S. & V.	$\frac{3}{4}$ in.	\$ 2.30
	Service box Old returned	Short $3\frac{1}{2} \times 4\frac{1}{2}$ Long $4\frac{1}{2} \times 5\frac{1}{2}$ Buff or Rdway		\$ 1.40
37	Ft. in.	Copper C.T. C.T.	Pipe at $\frac{3}{4}$	\$ 9.81
	Nipples	in. at		\$
	Bushings	to in. at		\$
	Red'g Inc'g	Coupl'gs	to in. at	\$
	Union	in. at		\$
	Meter	in. at		\$
	Lead Joints	at		\$
	Compound Joints	at		\$
2	Maintenance Foreman			\$ 1.25
	Hrs. Water Maint. Man-1	at		\$
	Hrs. Water Maint. Man-2	at		\$
	Hrs. Garage Foreman	at		\$
22	Hrs. Labor	at		\$ 8.94
2	Hrs. Compressor	at		\$ 3.00
	Compensation Ins. at \$	per C		\$ 21
	Trucking			\$ 1.00
	Pav't Patch			\$
				\$
				\$
				\$
	O'head			\$
				\$

Glen St. St. Pl. Ave. No. 516

Name of Owner

Labor and Mat'l. Report 1930

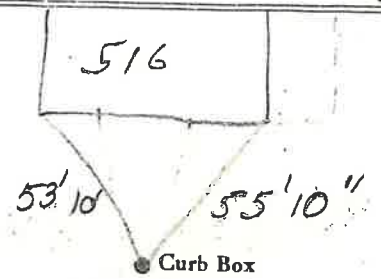

12 Main Elev. of Main at tap $4\frac{1}{2}$ FT.

Gate at • Gate at •

• Curb Box