

LABOR AND MATERIALS


1	Copper	Connection	3/4"	\$	2.71
1	Lead	Cock	3/4 in.	\$	3.83
1	Curb	Valve	3/4 in.	\$	3.83
		T. S. & V.			
1	Service box	Short 3 1/2 x 4 1/2		\$	4.69
	Old returned	Long 4 1/2 x 5 1/2		\$	
		Buff or Rdway		\$	
11	Ft. 3/4 in.	Copper	Pipe at 45	\$	4.95
		G.I.			
		G.I.			
	Nipples	in. at		\$	
	Bushings	to in. at		\$	
	Red'g			\$	
	Inc'g	Coupl'gs. to in. at		\$	
	Union	in. at		\$	
	Meter	in. at		\$	
	Lead Joints	at		\$	
	Compound Joints	at		\$	
	Maintenance Foreman			\$	38.42
8	Hrs. Water Maint. Man-1	at		\$	
	Hrs. Water Maint. Man-2	at 1.24		\$	9.92
3	Hrs. Garage Foreman	at 1.59		\$	4.77
21	Hrs. Labor	at 1.13		\$	23.73
2	Hrs. Compressor	at 1.50		\$	3.00
	Compensation Ins. at \$ 4.29	per C		\$	7.65
	Trucking			\$	1.50
	Pav't Patch			\$	13.44
	Tap by Gifford			\$	
		7-13-55		\$	
	O'head			\$	
				\$	74.19

60.75

Glen St. Pt. Ave. No. 527

Name of Owner Dillon

Labor and Mat'l. Report July 13 1955

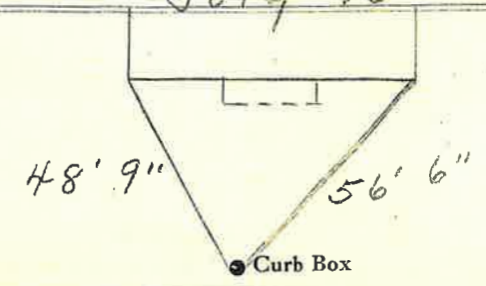

12" Main Elev. of Main at tap 4 1/2'

Gate at • Gate at

TAX ID # 302.15-8-4

• Curb Box

86