


LABOR AND MATERIALS

1 Copper } Connection ^{3/4"} \$ _____
 Lead }
 1 Curb } Cock } 3/4 in. \$ _____
 } Valve }
 } T.S. & V. }
 1 Service box { Short 3 1/2 x 4 1/2 }
 Old returned { Long 4 1/2 x 5 1/2 }
 { Buff or Rdway } \$ _____
 14 Ft. ^{3/4} in. { Copper } Pipe at. \$ _____
 } C.I. }
 } C.I. }
 Nipples in. at \$ _____
 Bushings to in. at \$ _____
 Red'g }
 Inc'g } Coupl'gs to in. at \$ _____
 Union in. at \$ _____
 Meter in. at \$ _____
 Lead Joints at \$ _____
 Compound Joints at \$ _____
 Maintenance Foreman \$ _____
 Hrs. Water Maint. Man-1 at \$ _____
 Hrs. Water Maint. Man-2 at \$ _____
 Hrs. Garage Foreman at \$ _____
 Hrs. Labor at \$ _____
 Hrs. Compressor at \$ _____
 Compensation Ins. at \$ _____ per C \$ _____
 Trucking \$ _____
 Pav't Patch \$ _____
 Tap by Gissord & Co \$ _____
 4-26-50 \$ _____
 O'head \$ _____
 \$ _____

St. Glen
~~Pl.~~
 Ave. No. 537

Name of Owner Baker.

Labor and Mat'l. Report April 26 1960

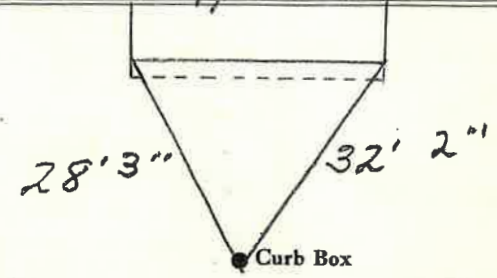

12" Main Elev. of Main at tap 5"

Gate at • Gate at
 TAX ID # 302.15-3-12

• Curb Box