

LABOR AND MATERIALS

1	Copper	Connection <sup>3/4"</sup>	\$ 2.41
	Lead		
1	Curb	Cock Valve } <sup>3/4</sup> in.	\$ 3.41
1	Service box	Short <sup>3 1/2</sup> x <sup>4 1/2</sup> Long <sup>4 1/2</sup> x <sup>5 1/2</sup> Buff or Rdway	\$ 4.18
	Old returned		
11	Ft. <sup>3/4</sup> in.	Copper } Pipe at 40	\$ 4.40
		G.I. }	
		G.I. }	
	Nipples	in. at	\$
	Bushings	to in. at	\$
	Red'g } Inc'g }	Coupl'gs to in. at	\$
	Union	in. at	\$
	Meter	in. at	\$
	Lead Joints	at	\$
	Compound Joints	at	\$
	Maintenance Foreman		\$
	Hrs. Water Maint. Man—1	at	\$ 32.87
10	Hrs. Water Maint. Man—2	at 124	\$ 12.40
	Hrs. Garage Foreman	at	\$
19	Hrs. Labor—	at 113	\$ 21.47
	Hrs. Compressor	at	\$
	Compensation Ins. at \$3.861	per C.	\$ 1.31
	Trucking		\$ 1.50
	Pav't Patch		\$
	Tap by Gifford 12-2-54		\$ 4.40
	O'head		\$
			\$
			\$
			\$
			\$ 59.48

57.08

99-54


Glen St.

St. Pl. 539  
Ave. No.

Name of Owner

Carr

Labor and Mat'l. Report Dec. 2 1954

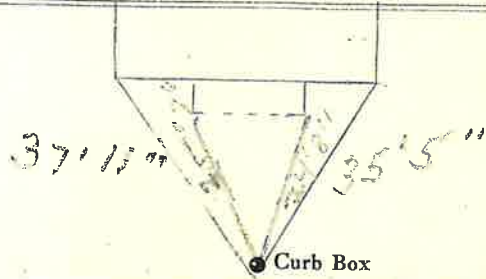

● Curb Box

12" Main

Elev. of Main at tap 4 1/2"

Gate at ●

● Gate at

● Curb Box