


LABOR AND MATERIALS

1	Copper bead	Connection	1"	\$	_____
1	Curb	Cock Valve T.S. & V.	1 in.	\$	_____
1	Service box	Short 3-1/2 x 4-1/2		\$	_____
	Old returned	Long 4-1/2 x 5-1/2		\$	_____
38	Ft.	1 in.	Copper Est. Est.	Pipe at	\$ _____
	Nipples		in.	at	\$ _____
	Bushings		to	in. at	\$ _____
	Red'g				\$ _____
	Inc'g				\$ _____
	Union		in.	at	\$ _____
	Meter		in.	at	\$ _____
					\$ _____
	Compound Joints at				\$ _____
	Maintenance Foreman				\$ _____
	Hrs. Water Maint. Man - 1 at				\$ _____
	Hrs. Water Maint. Man - 2 at				\$ _____
	Hrs. Garage Foreman		at		\$ _____
	Hrs. Labor		at		\$ _____
	Hrs. Compressor at				\$ _____
					\$ _____
	Trucking				\$ _____
	Pav't Patch				\$ _____
					\$ _____
					\$ _____
					\$ _____
					\$ _____

Glen St. No. 542
 Name of Owner _____

Labor and Mat'l. Report 19 34, May 9

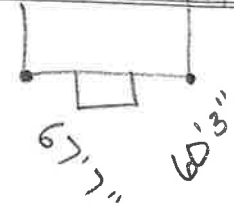

● Curb Box

12 Main Elev. of Main at tap 3 1/2
 Gate at ● Gate at ●

● Curb Box

Old tap shut off