

LABOR AND MATERIALS

1 Copper } Connection $\frac{3}{4}$ " \$
 Lead }
 1 Curb } Cook Valve } $\frac{3}{4}$ " in. Or seal \$
 T.S. & V. }
 1 Service box } Short $3\frac{1}{2}$ x $4\frac{1}{2}$ } 4×5 \$
 Old returned } Long $4\frac{1}{2}$ x $5\frac{1}{2}$ }
 Buff or Rdway }
 35 Ft. $\frac{3}{4}$ " in. } Copper } Pipe at \$
 C.I. }
 C.I. }
 Nipples in. at \$
 Bushings to in. at \$
 Red'g }
 Inc'g } Coupl'gs to in. at \$
 Union in. at \$
 Meter in. at \$
 Lead Joints at \$
 Compound Joints at \$
 Maintenance Foreman \$
 Hrs. Water Maint. Man-1 at \$
 Hrs. Water Maint. Man-2 at \$
 Hrs. Garage Foreman at \$
 Hrs. Labor at \$
 Hrs. Compressor at \$
 Compensation Ins. at \$ per C \$
 Trucking \$
 Pay't Patch \$
 Tap by Peck & Co. \$
 10-5-71 \$
 O'head \$

St.

Glen


Pl. Ave. No. 543

Name of Owner

Lutheran Church Rectory

Labor and Mat'l. Report

Oct. 5 1971

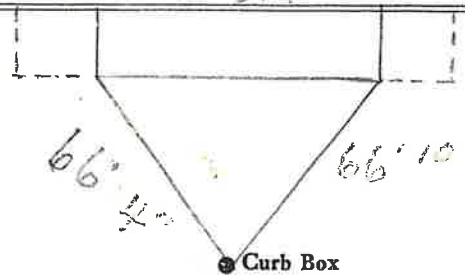

● Curb Box

Tap on Bowman Ave.

6" Main

Elev. of Main at tap 4'

Gate at ●

● Gate at

● Curb Box

Nothing on back of this card

~~By~~ *Glen* St. Pl. Ave. No. *543*

Name of Owner
Lutheran Church Rectory

Labor and Mat'l. Report 19

30'9" 41'5" Curb Box

Glen St shut off

Main Elev. of Main at tap

Gate at • Gate at

• Curb Box

LSM-SC-6-1-67