


# LABOR AND MATERIALS

1	Copper Lead	} Connection	3/4"	\$	
1	Curb F.S. & V.		} 3/4" in. (Orisea)		
1	Service box Old returned	{		Short 3-1/2 x 4-1/2	\$
			Long 4-1/2 x 5-1/2		
36	Ft. 3/4 in.	{ Copper Est. Est.	} Pipe at	\$	
	Nipples		in. at	\$	
	Bushings		to in. at	\$	
	Red'g				
	Inc'g				
	Union		in. at	\$	
	Meter		in. at	\$	
				\$	
	Compound Joints at			\$	
	Maintenance Foreman			\$	
	Hrs. Water Maint. Man - 1 at			\$	
	Hrs. Water Maint. Man - 2 at			\$	
	Hrs. Garage Foreman		at	\$	
	Hrs. Labor		at	\$	
	Hrs. Compressor at			\$	
				\$	
	Trucking			\$	
	Pav't Patch			\$	
				\$	
				\$	
				\$	
				\$	

St. Glen Ave. No. 546  
 Name of Owner N. Wm Wagar 2<sup>ND</sup>  
 Labor and Mat'l. Report 19 64, July 8

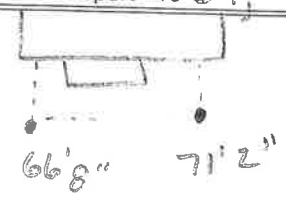

● Curb Box  
12" Main Elev. of Main at tap 4'  
 Gate at ● Gate at ●

● Curb Box  
 SEWER LATERAL IS  
 11 FT NORTH OF MANHOLE.