

## LABOR AND MATERIALS

..... Copper	}	Connection .....	..... \$			
..... Lead						
..... Curb	}	Cock Valve T. S. & V. .... in. ....	..... \$			
..... Service box				}	Short 3½X4½ Long 4½X5½ Buff or Rdway .....	..... \$
..... Old returned						
..... Ft. .... in.	}	Copper G. I. C. I. .... Pipe at .....	..... \$			
..... Nipples				..... in. at .....		
..... Bushings				..... to .....		
..... Red'g	}	Coupl'gs .... to .....	..... \$			
..... Inc'g						
..... Union	..... in. at .....	..... \$				
..... Meter	..... in. at .....	..... \$				
..... Lead Joints	at .....	..... \$				
..... Compound Joints	at .....	..... \$				
..... Hrs. Water Maint. Man—1	at .....	..... \$				
..... Hrs. Water Maint. Man—2	at .....	..... \$				
..... Hrs. Labor—	at .....	..... \$				
..... Hrs. Labor—	at .....	..... \$				
..... Hrs. Compressor	at .....	..... \$				
..... Compensation Ins. at \$	per C .....	..... \$				
..... Trucking	.....	..... \$				
..... Pav't Patch	.....	..... \$				
..... O'head	.....	..... \$				
			..... \$			

St. Glen  
 Pl. 611  
 Ave. No. 611

---

Name of Owner  
W. C. McCowan

Measured in 9-4-1953

Labor and Mat'l. Report

● Curb Box

---

12 Main Elev. of Main at tap ?

Gate at ● ● Gate at

---


● Curb Box

LABOR AND MATERIALS

Copper } Connection \_\_\_\_\_ \$ \_\_\_\_\_  
 ad }  
 Curb } Cock } \_\_\_\_\_ in. \_\_\_\_\_ \$ \_\_\_\_\_  
 } Valve }  
 } T. S. & V. }  
 Service box { Short 3 1/2 x 4 1/2 }  
 returned { Long 4 1/2 x 5 1/2 } \_\_\_\_\_ \$ \_\_\_\_\_  
 3/4 in. { Copper } Pipe at \_\_\_\_\_ \$ \_\_\_\_\_  
 } C.I. }  
 } C.I. }  
 Pipes \_\_\_\_\_ in. at \_\_\_\_\_ \$ \_\_\_\_\_  
 Things \_\_\_\_\_ to \_\_\_\_\_ in. at \_\_\_\_\_ \$ \_\_\_\_\_  
 Coupl'gs \_\_\_\_\_ to \_\_\_\_\_ in. at \_\_\_\_\_ \$ \_\_\_\_\_  
 on \_\_\_\_\_ in. at \_\_\_\_\_ \$ \_\_\_\_\_  
 er \_\_\_\_\_ in. at \_\_\_\_\_ \$ \_\_\_\_\_  
 \_\_\_\_\_ \$ \_\_\_\_\_  
 Compound Joints at \_\_\_\_\_ \$ \_\_\_\_\_  
 Maintenance Foreman \_\_\_\_\_ \$ \_\_\_\_\_  
 Water Maint. Man—1 at \_\_\_\_\_ \$ \_\_\_\_\_  
 Water Maint. Man—2 at \_\_\_\_\_ \$ \_\_\_\_\_  
 Garage Foreman \_\_\_\_\_ at \_\_\_\_\_ \$ \_\_\_\_\_  
 Labor— \_\_\_\_\_ at \_\_\_\_\_ \$ \_\_\_\_\_  
 Compressor at \_\_\_\_\_ \$ \_\_\_\_\_  
 \_\_\_\_\_ \$ \_\_\_\_\_  
 \_\_\_\_\_ \$ \_\_\_\_\_  
St. \_\_\_\_\_  
 Pt. \_\_\_\_\_  
 Ave. No. GLEN 611  
 Name of Owner \_\_\_\_\_

Labor and Mat'l. Report \_\_\_\_\_ 19 97

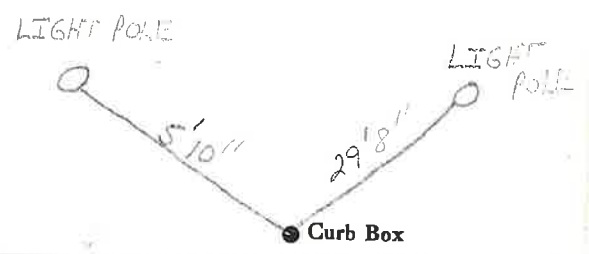


Main \_\_\_\_\_ Elev. of Main at tap \_\_\_\_\_  
 Gate at ● \_\_\_\_\_ Gate at ● \_\_\_\_\_

● Curb Box  
 TAP FOR BLD. IN REAR

# LABOR AND MATERIALS

_____ Copper } Connection _____ \$ _____	
_____ Lead } _____	
_____ Curb } Cock Valve } _____ in. _____ \$ _____	
_____ T.S. & V. } _____	
_____ Service box { Short 3-1/2 x 4-1/2 } _____ \$ _____	
_____ Old returned { Long 4-1/2 x 5-1/2 } _____	
_____ Ft. _____ in. { Copper } Pipe at _____ \$ _____	
_____ G.I. } _____	
_____ C.I. } _____	
_____ Nipples _____ in. at _____ \$ _____	
_____ Bushings _____ to _____ in. at _____ \$ _____	
_____ Red'g _____	
_____ Inc'g _____	
_____ Union _____ in. at _____ \$ _____	
_____ Meter _____ in. at _____ \$ _____	
_____ _____ \$ _____	
_____ Compound Joints at _____ \$ _____	
_____ Maintenance Foreman _____ \$ _____	
_____ Hrs. Water Maint. Man - 1 at _____ \$ _____	
_____ Hrs. Water Maint. Man - 2 at _____ \$ _____	
_____ Hrs. Garage Foreman _____ at _____ \$ _____	
_____ Hrs. Labor _____ at _____ \$ _____	
_____ Hrs. Compressor at _____ \$ _____	
_____ _____ \$ _____	
_____ Trucking _____ \$ _____	
_____ Pav't Patch _____ \$ _____	
_____ _____ \$ _____	
_____ _____ \$ _____	
GLEN St. Pl. Ave. No. 611  
 Name of Owner OUTSIDE CLEAN OUT  
 Labor and Mat'l. Report JULY 2014

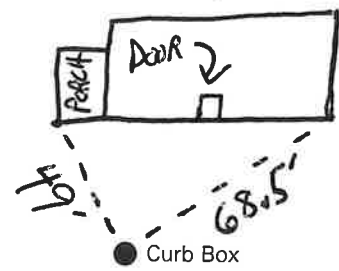

\_\_\_\_\_ Main Elev. of Main at tap \_\_\_\_\_  
 Gate at ● Gate at ●  
 \_\_\_\_\_  
 ● Curb Box