

LABOR AND MATERIALS

Copper	} Connection		\$	
Lead				
Curb	} Cock	in.	\$	
				} Valve
Service box	} Short 3 1/2 x 4 1/2			
Old returned		} Long 4 1/2 x 5 1/2		
			} Buff or Rdway	
Ft.	} Pipe at			\$
in.		} Copper		
			} G. I.	
Nipples	in. at			\$
Bushings	to in. at		\$	
Red'g	} Coupl'gs	to in. at	\$	
Inc'g				
Union	in. at		\$	
Meter	in. at		\$	
Lead Joints	at		\$	
Compound Joints	at		\$	
Maintenance Foreman			\$	
Hrs. Water Maint. Man—1	at		\$	
Hrs. Water Maint. Man—2	at		\$	
Hrs. Garage Foreman	at		\$	
Hrs. Labor—	at		\$	
Hrs. Compressor	at		\$	
Compensation Ins. at \$	per C		\$	
Trucking			\$	
Pav't Patch			\$	
			\$	
			\$	
O'head			\$	
			\$	

FIRE RO.

-TWO 2" LINES


St. GLEN
Pl.
Ave. No.

Name of Owner

Labor and Mat'l. Report

AUG 26

1923

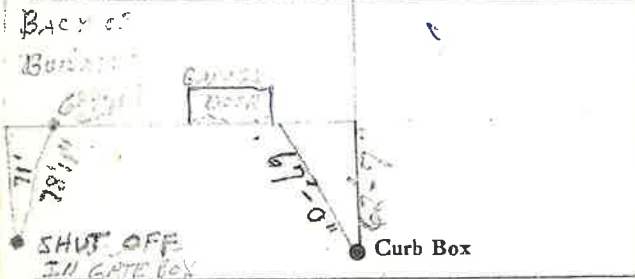

SKI TRAILS Elev. of Main at tap

Gate at • Gate at

• Curb Box