

LABOR AND MATERIALS


|    |                       |                     |              |    |
|----|-----------------------|---------------------|--------------|----|
| 1  | Copper                | Connection          | 3/4"         | \$ |
| 1  | Lead                  | Cock                |              | \$ |
| 1  | Curb                  | Valve               | 3/4" oriseat | \$ |
|    |                       | T.S. & V.           |              | \$ |
| 1  | Service box           | Short 3 1/2 x 4 1/2 |              | \$ |
|    | Old returned          | Long 4 1/2 x 5 1/2  |              | \$ |
|    |                       | Buff or Rdway       |              | \$ |
| 13 | Ft.                   | 3/4 in. Copper      | Pipe at      | \$ |
|    |                       | G.I.                |              | \$ |
|    |                       | G.I.                |              | \$ |
|    | Nipples               | in. at              |              | \$ |
|    | Bushings              | to in. at           |              | \$ |
|    | Red'g                 |                     |              | \$ |
|    | Inc'g                 | Coupl'gs to in. at  |              | \$ |
|    | Union                 | in. at              |              | \$ |
|    | Meter                 | in. at              |              | \$ |
|    | Lead Joints           | at                  |              | \$ |
|    | Compound Joints       | at                  |              | \$ |
|    | Maintenance Foreman   |                     |              | \$ |
|    | Hrs. Water Maint. Man | 1 at                |              | \$ |
|    | Hrs. Water Maint. Man | 2 at                |              | \$ |
|    | Hrs. Garage Foreman   | at                  |              | \$ |
|    | Hrs. Labor            | at                  |              | \$ |
|    | Hrs. Compressor       | at                  |              | \$ |
|    | Compensation Ins.     | at \$ per C         |              | \$ |
|    | Trucking              |                     |              | \$ |
|    | Pav't Patch           |                     |              | \$ |
|    | Tap by Kelly & Co.    |                     |              | \$ |
|    |                       | 9-30-63             |              | \$ |
|    | O'head                |                     |              | \$ |

St. PL  
Ave. No. 86-90

Glen

Name of Owner  
J. E. Sawyer & Co

Labor and Mat'l. Report Sept. 30 1963

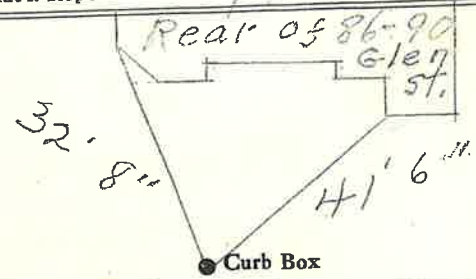

6" Tap in alley way  
Main Elev. of in rear  
Main at tap 4 1/2'

Gate at ● Gate at ●

● Curb Box  
This Tap measured  
in from rear of  
86-90 Glen St.