

LABOR AND MATERIALS


1	Copper	Connection	\$
	Lead		
1	Curb	Cock Valve T.S. & V. } 3/4 in.	\$
1	Service box	Short 3 1/2 x 4 1/2	\$
	Old returned	Long 4 1/2 x 5 1/2	
		Buff or Rdway	
	Ft. 3/4 in.	Copper } Pipe at	\$
		G. I. }	
		C. I. }	
	Nipples	in. at	\$
	Bushings	to in. at	\$
	Red'g		
	Inc'g	Coupl'gs to in. at	\$
	Union	in. at	\$
	Meter	in. at	\$
	Lead Joints	at	\$
	Compound Joints	at	\$
	Maintenance Foreman		\$
	Hrs. Water Maint. Man-1	at	\$
	Hrs. Water Maint. Man-2	at	\$
	Hrs. Garage Foreman	at	\$
	Hrs. Labor	at	\$
	Hrs. Compressor	at	\$
	Compensation Ins. at \$	per C	\$
	Trucking		\$
	Pav't Patch		\$
			\$
			\$
	O'head		\$
			\$

Glen St. 94-98  
 Pt. Ave. No.

Name of Owner Old Salvation Army Citadel Now owned by Glen Falls Post Co.

Labor and Matl. Report Dec 21 1956

Found Curb box & Measured in

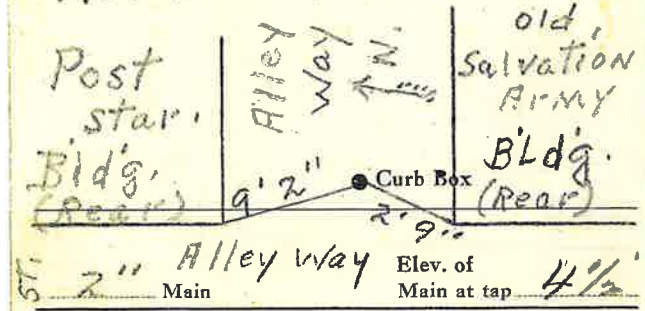

Gate at • • Gate at

• Curb Box  
 Old Fashion Stop  
 Turns Round  
 & Round.