


Labor and Materials


Copper } Connection.....	\$
Lead }	\$
Curb { Cock }	\$
{ Valve }	\$
{ T. S. & V. }	\$
Service Box { Short 3 1/2 x 4 1/2 }	\$
Old returned { Long 4 1/2 x 5 1/2 }	\$
{ Buff. or Rdway }	\$
Ft. in. { Copper } Pipe at.....	\$
{ Galv. Iron }	\$
{ Cast Iron }	\$
Nipples..... in. at.....	\$
Bushings..... to..... in. at.....	\$
Red'g } Couplings..... to..... in. at.....	\$
Inc'g }	\$
Union. <i>at</i> in. at.....	\$
Meter..... in. at.....	\$
Lbs Br. Stone at.....	\$
Lbs. Sand at.....	\$
Bags Cement at.....	\$
Paving Brick { Mack } at.....	\$
{ Red }	\$
{ Asphalt }	\$
Lead Joints at.....	\$
Leadite Joints at.....	\$
Hrs. Foreman at.....	\$
Hrs. Common Labor at.....	\$
Hrs. Common Labor at.....	\$
Hrs. Mason at.....	\$
Hrs. Mason's Helper at.....	\$
Hrs. Compressor at.....	\$
Compensation Ins.....	\$
Trucking.....	\$
Builders' Use of Water.....	\$
Total \$.....	

Labor and Material Report

19

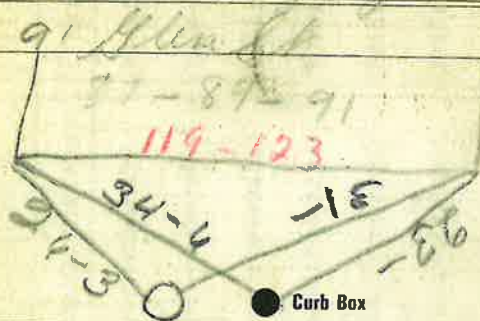

RAZED

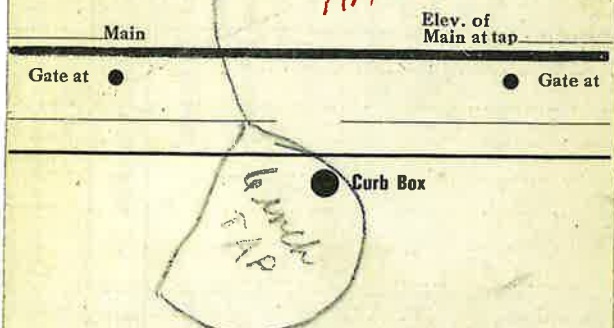

Sprinkler System
shut off in street

Labor and Materials

Lead Connection	\$	
1. Curb Box 6" Gate & Sleeve	\$	48.90
1. Service Box { Short 2 1/2 x 4 1/2 } Old returned { Long 4 1/2 x 5 1/2 } Buffalo	\$	5.03
19. Ft 6" in. Pipe C.I. Pipe	\$	28.00
Nipples..... in. at	\$	
Bushings..... in. at	\$	
Red'g Coup... to... in. at	\$	
Inc'g Coup... to... in. at	\$	
Union... in. at	\$	
Meter... in. at	\$	
Cu. Yds. Br. Stone at	\$	
Cu. Yds. Sand at	\$	
Bags Cement at	\$	
Pav. Brick { Mack Red Asphalt } at	\$	
26. Hrs. Foreman at	\$	13.06
53. Hrs. Com. Labor at	\$	19.88
Hrs. Mason at	\$	
Hrs. at	\$	
Hrs. at	\$	
Builders' Use of Water	\$	
Man 4" joints	at	\$	2.46
Lead & jute	at	\$.13
Pavement	at	\$	
Total		\$	117.90

Labor and Material Report *Sept 22-23-24-25* 1926

6" Tap at 89 Glen St

119-123

● Curb Box

Main

Elev. of Main at tap

Gate at ●

● Gate at

● Curb Box

Wm