

LABOR AND MATERIALS

Copper	}	Connection		\$	
Lead					
Curb	}	Cock	} in.	\$	
		Valve			
		T. S. & V.			
Service box	}	Short 3½ x 4½	}	\$	
Old returned		Long 4½ x 5½			
Ft. 1	}	Copper	} Pipe at	\$	
in.		Galv.			
Nipples	in.	at		\$	
Bushings	to	in.	at	\$	
Red'g	}	Coupl'gs	to	in.	at
Inc'g					
Union	in.	at		\$	
Meter	in.	at		\$	
Compound Joints	at			\$	
Maintenance Foreman				\$	
Hrs. Water Maint. Man-1	at			\$	
Hrs. Water Maint. Man-2	at			\$	
Hrs. Garage Foreman	at			\$	
Hrs. Labor	at			\$	
Hrs. Compressor	at			\$	
Trucking				\$	
Pav't Patch				\$	
				\$	
				\$	
Glen


St.
 Pl.
 Ave. No. 134-38

Name of Owner

Louis Wittko

Labor and Mat'l. Report

Summer 19 85

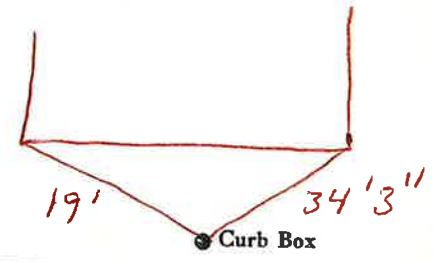

	Elev. of	
Main	Main at tap	
Gate at ●		● Gate at

● Curb Box