

LABOR AND MATERIALS


1 Copper } Connection 1" _____ \$ _____
 Lead }
 1 Curb } Cock } 1" in. _____ \$ _____
 Valve }
 T.S. & V. }
 1 Service box { Short 2-1/2 x 4-1/2 } _____ \$ _____
 Old returned { Long 4-1/2 x 5-1/2 }
 50 Ft. 1" in. { Copper } Pipe at _____ \$ _____
 Nipples _____ in. at _____ \$ _____
 Bushings _____ to _____ in. at _____ \$ _____
 Red'g _____
 Inc'g _____
 Union _____ in. at _____ \$ _____
 Meter _____ in. at _____ \$ _____
 _____ \$ _____
 Compound Joints at _____ \$ _____
 Maintenance Foreman _____ \$ _____
 Hrs. Water Maint. Man - 1 at _____ \$ _____
 Hrs. Water Maint. Man - 2 at _____ \$ _____
 Hrs. Garage Foreman _____ at _____ \$ _____
 Hrs. Labor _____ at _____ \$ _____
 Hrs. Compressor at _____ \$ _____
 _____ \$ _____
 Trucking _____ \$ _____
 Pav't Patch _____ \$ _____
 _____ \$ _____
 _____ \$ _____
 _____ \$ _____
 _____ \$ _____

GLEN

St. _____
 Ass. No. 140-142

Name of Owner

Labor and Mat'l. Report 19

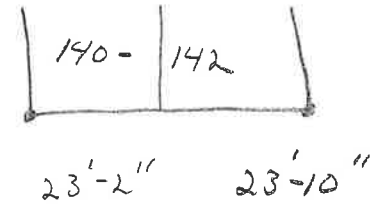

● Curb Box

12" Main

Elev. of Main at tap 52'

Gate at ●

● Gate at

● Curb Box