

2-1" Cop to Cop Couplings
LABOR AND MATERIALS

1	Copper	Connection	1"	\$	4.70
1	Lead				
1	Curb	Cock Valve T.S. & V.	1 in.	\$	5.32
1	Service box	Short 3 1/2 x 4 1/2		\$	4.70
	Old returned	Long 4 1/2 x 5 1/2			
		Buff or Rdway			
63	Ft. 1 in.	Copper G.I. C.I.	Pipe at 43	\$	27.09
	Nipples	in. at		\$	
	Bushings	to in. at		\$	
	Red'g Inc'g	Coupl'gs to in. at		\$	
	Union	in. at		\$	
	Meter	in. at		\$	
	Lead Joints	at		\$	
	Compound Joints	at		\$	
6	Hrs. Water Maint. Man-1	at 1.23		\$	7.38
8	Hrs. Water Maint. Man-2	at 1.13		\$	9.04
19	Hrs. Labor - Fman	at 1.33 1/2		\$	25.33
47	Hrs. Labor	at 1.02		\$	47.94
4	Hrs. Compressor	at 1.50		\$	6.00
	Compensation Ins.	at \$ 2.66 per C.		\$	2.39
	Trucking			\$	4.00
	Pav't Patch	No Chg (Sewer)		\$	
				\$	
				\$	
				\$	
	O'head			\$	

Tap by Gifford
 10-9-51

Glen


St. 146
 Pl. 148
 Ave. No.

Name of Owner

110 Glen St. Realty Co.

Labor and Mat'l. Report

Oct. 9 1951

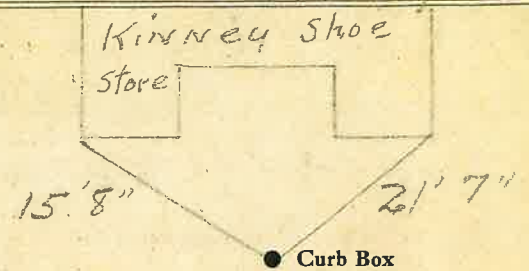

12" Main

Elev. of Main at tap 5'

Gate at ●

● Gate at

● Curb Box