

LABOR AND MATERIALS

1/2 Copper Connection _____ \$ _____

_____ Curb } Cock
 _____ Valve } _____ in. \$ _____
 _____ T.S. & V. }

_____ Service box { Short 3-1/2 x 4-1/2 } _____ \$ _____
 _____ Old returned { Long 4-1/2 x 5-1/2 }

_____ Ft. _____ in. { Copper } Pipe at _____ \$ _____
 _____ G.I.
 _____ C.I. }

_____ Nipples _____ in. at _____ \$ _____

_____ Bushings _____ to _____ in. at _____ \$ _____

_____ Red'g _____

_____ Inc'g _____

_____ Union _____ in. at _____ \$ _____

_____ Meter _____ in. at _____ \$ _____

_____ Compound Joints at _____ \$ _____

_____ Maintenance Foreman _____ \$ _____

_____ Hrs. Water Maint. Man - 1 at _____ \$ _____

_____ Hrs. Water Maint. Man - 2 at _____ \$ _____

_____ Hrs. Garage Foreman _____ at _____ \$ _____

_____ Hrs. Labor _____ at _____ \$ _____

_____ Hrs. Compressor at _____ \$ _____

_____ Trucking _____ \$ _____

_____ Pav't Patch _____ \$ _____


LOOK AT HOW STS
 RECONSTRUCTION 11-08-06

GEN

St. Pl. Ave. No. 166

Name of Owner

Labor and Mat'l. Report 11-08-06

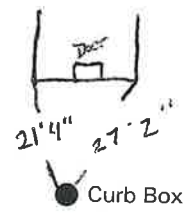

_____ Main Elev. of Main at tap _____

Gate at ● Gate at ●

● Curb Box

2 Boxes
 Shut off Box to the South