


LABOR AND MATERIALS

1	Copper Lead	Connection	6" SPLIT TREE	\$
1	Curb	Goek Valve K.S. & V.	6" in.	\$
1	Service box	Short 3-1/2 x 4-1/2 Long 4-1/2 x 5-1/2	GATE	\$
36	Ft. 6" in.	Copper C.I.	Pipe at	\$
	Nipples		in. at	\$
	Bushings		to in. at	\$
	Red'g			
	Inc'g			
	Union		in. at	\$
	Meter		in. at	\$
				\$
	Compound Joints at			\$
	Maintenance Foreman			\$
	Hrs. Water Maint. Man - 1 at			\$
	Hrs. Water Maint. Man - 2 at			\$
	Hrs. Garage Foreman		at	\$
	Hrs. Labor		at	\$
	Hrs. Compressor at			\$
				\$
	Trucking			\$
	Pav't Patch			\$
				\$
				\$
				\$
				\$

St. No. 167
 GLEN
 Name of Owner ELKS BLD.
 2 RIDGE

Labor and Mat'l. Report 1927, OCT. 3

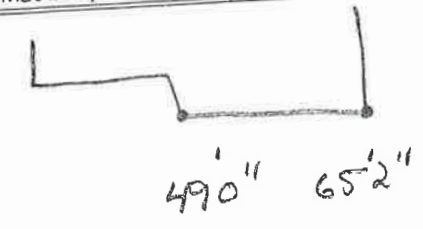

10" Main
 Elev. of Main at tap 5'
 Gate at ● Gate at ●
 Curb Box ●

6" LINE

See #8 - #10 - #12 Ridge