


# LABOR AND MATERIALS

1	Copper	Connection	1"	\$
1	Curb	Cock Valve T.C. & V.	1" in.	\$
1	Service box Old returned	{ Short 3-1/2 x 4-1/2 Long 4-1/2 x 5-1/2 }		\$
10	Ft.	1" in. { Copper } Pipe at		\$
	Nipples		in. at	\$
	Bushings		to in. at	\$
	Red'g			
	Inc'g			
	Union		in. at	\$
	Meter		in. at	\$
	Compound Joints	at		\$
	Maintenance Foreman			\$
	Hrs. Water Maint. Man - 1	at		\$
	Hrs. Water Maint. Man - 2	at		\$
	Hrs. Garage Foreman	at		\$
	Hrs. Labor	at		\$
	Hrs. Compressor	at		\$
	Trucking			\$
	Pav't Patch			\$
				\$
				\$
St. GLEN  
 Ave. No. 173-175  
 Name of Owner \_\_\_\_\_

Labor and Mat'l. Report 1929, MAY 22

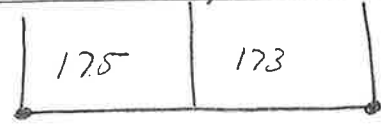

16'-0"      24'2"

● Curb Box

12" Main      Elev. of Main at tap 5 1/2'

Gate at ●      ● Gate at

● Curb Box