

LABOR AND MATERIALS


- 1 Copper } Connection " _____ \$
- 1 Curb } Cock } _____ \$
- 1 Curb } Valve } _____ \$
- 1 Service box { Short 3-1/2 x 4-1/2 } _____ \$
- 1 Old returned { Long 4-1/2 x 5-1/2 } _____ \$
- 10 Ft. 1" in. { Copper } Pipe at _____ \$
- 1 Nipples 1" in. at _____ \$
- 1 Bushings 1/2" to 1" in. at _____ \$
- _____ Red'g _____ \$
- _____ Inc'g _____ \$
- _____ Union _____ in. at _____ \$
- _____ Meter _____ in. at _____ \$
- _____ _____ \$
- _____ Compound Joints at _____ \$
- _____ Maintenance Foreman _____ \$
- _____ Hrs. Water Maint. Man - 1 at _____ \$
- _____ Hrs. Water Maint. Man - 2 at _____ \$
- _____ Hrs. Garage Foreman _____ at _____ \$
- _____ Hrs. Labor _____ at _____ \$
- _____ Hrs. Compressor at _____ \$
- _____ _____ \$
- _____ Trucking _____ \$
- _____ Pav't Patch _____ \$
- _____ _____ \$
- _____ _____ \$
GLEN

St. Ave. No. 179-181

Name of Owner

Labor and Mat'l. Report 19 29, MAY 22

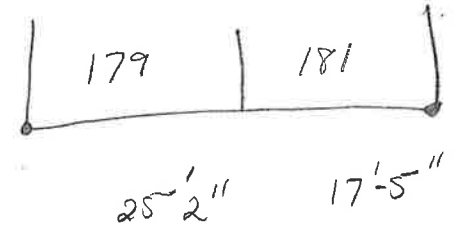

12" Main

Elev. of Main at tap 5 1/2'

Gate at ●

● Gate at

● Curb Box