
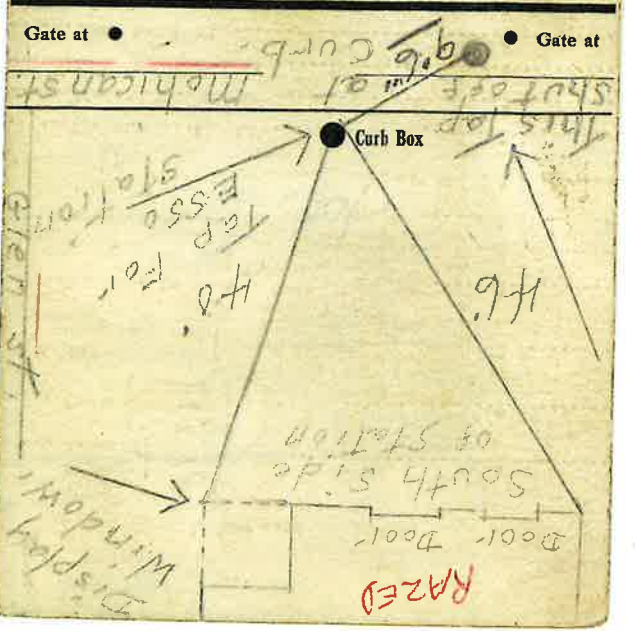



**Labor and Materials**

Copper } Connection. $\frac{3}{4}$ .....	\$ 1.50
Lead } .....	
1... Curb { Cock Valve T.S.&V. } $\frac{3}{4}$ in .....	\$ 1.70
✓... Service Box { Short $3\frac{1}{2} \times 4\frac{1}{2}$ Long $4\frac{1}{2} \times 5\frac{1}{2}$ } .....	\$ 1.44
Old returned { Buff. or R&W. } .....	
26 Ft. $\frac{3}{4}$ in. { Copper Galv. Iron Cast Iron } Pipe at .....	\$ 4.24
..... Nipples ..... in. at .....	\$
..... Bushings ..... to ..... in. at .....	\$
..... Red'g Inc'g } Couplings..... to ..... in. at .....	\$
..... Union..... in. at .....	\$
..... Meter..... in. at .....	\$
..... Lbs. Br. Stone at .....	\$
..... Lbs. Sand at .....	\$
..... Bags Cement at .....	\$
..... Paving Brick { Mack Red Asphalt } at .....	\$
..... Lead Joints at .....	\$
..... Leadite Joints at .....	\$
70 Hrs. Foreman at $\frac{FVC}{62.12}$ .....	\$ 12.50
42 Hrs. Common Labor at $\frac{50}{50}$ .....	\$ 21.-
37 Hrs. Common Labor at $\frac{45}{45}$ .....	\$ 14.40
..... Hrs. Mason at .....	\$
..... Hrs. Masons Helper at .....	\$
A... Hrs. Compressor at .....	\$ 6.-
..... Compensation Ins .....	\$ 1.72
..... Trucking .....	\$ 6.-
..... Builders Use of Water $\frac{Pav. Patch}{9}$ .....	\$ 9.-
<b>Total \$ 80.20</b>	

32 4' dia. 20' tap in back of  
38   
See below 40'2" 37'0"  
Curb Box 6' dia ST

6 Main Elev of Main at tap 11'  
Mehican ST.



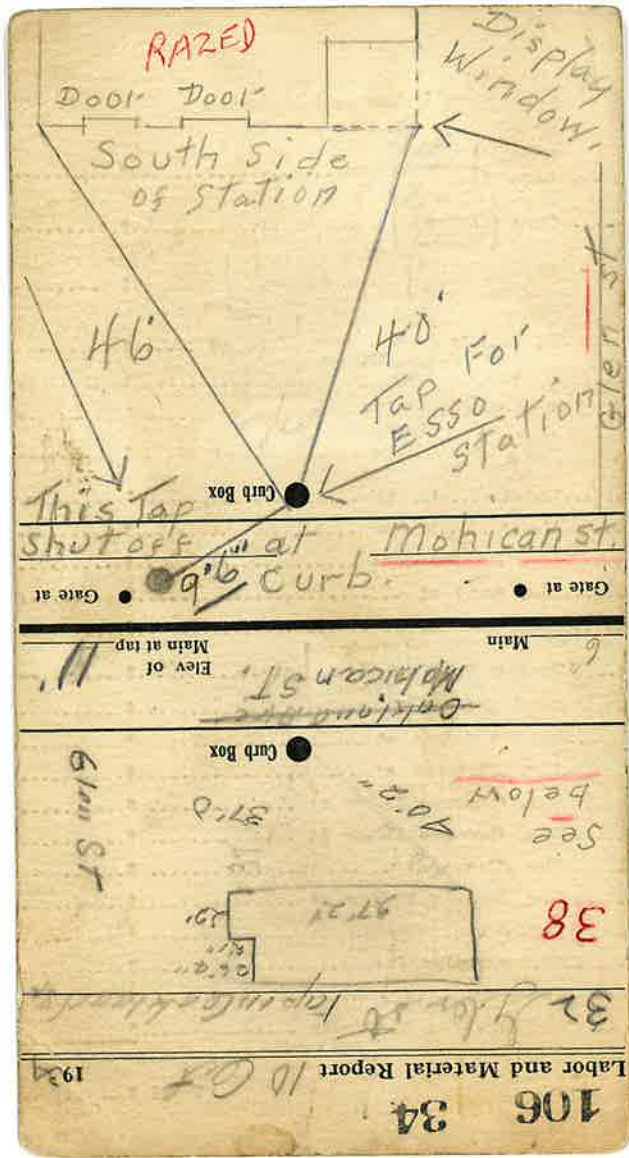

RAZED

Door Door

Display Window

South side of station

46'

40' For Tap ESSO Station

Curb Box

This Tap shut off at

Mohican St

Gate at

9.6'

curb

Gate at

Main at tap

Main

Elev of Mohican St.


Curb Box

6111 ST

37.2'

See below 70.2'

38

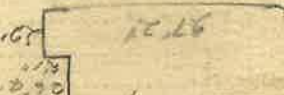

32' Mohican St


Labor and Material Report 10 Oct 1934

106 34

Memo.

Top for Fosso Station  
Glen & Oakland.

Tap on Oakland

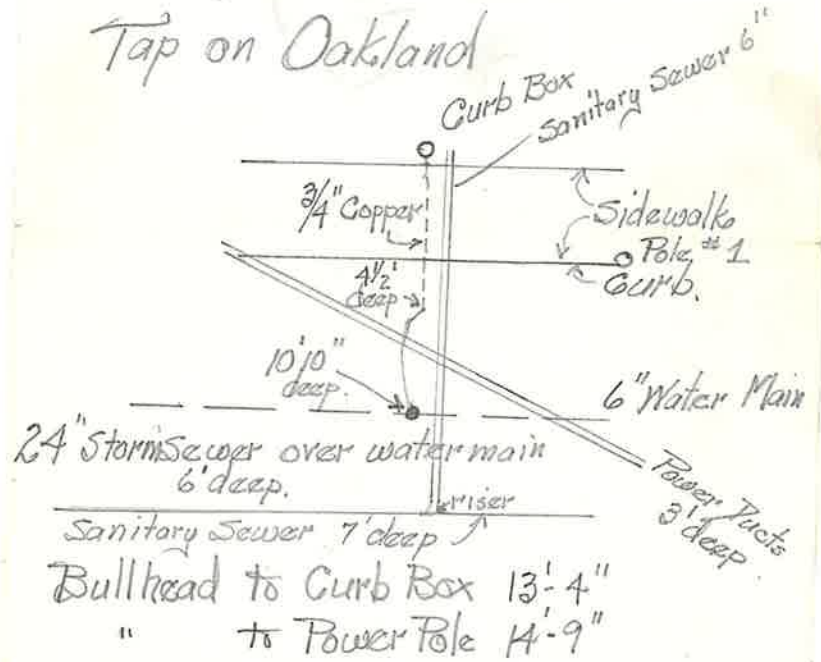

"Where the Promise is Fulfilled"

PRINTING DEPARTMENT, GLENS FALLS POST COMPANY  
GUY J. DAMIANO, Manager TELEPHONE: RX2-3131

# 38

Glen St.

---

Memo