

LABOR AND MATERIALS

Copper Lead	} Connection		\$
1 Curb		} Cook Valve T.S. & V.	12" x 6" in.
1 Service box Old returned	} Short 3 1/2 x 4 1/2 Long 4 1/2 x 5 1/2 Buff or Rdway		
19 Ft. 6 in.		} Copper G.I. C.I.	Pipe at
Nipples	in. at		\$
Bushings	to in. at	\$	
Red'g Inc'g	} Coupl'gs	to in. at	\$
Union		in. at	\$
Meter	in. at	\$	
Lead Joints	at	\$	
Compound Joints	at	\$	
Maintenance Foreman		\$	
Hrs. Water Maint. Man-1	at	\$	
Hrs. Water Maint. Man-2	at	\$	
Hrs. Garage Foreman	at	\$	
Hrs. Labor	at	\$	
Hrs. Compressor	at	\$	
Compensation Ins. at \$	per C.	\$	
Trucking		\$	
Pav't Patch		\$	
		\$	
		\$	
O'head		\$	
		\$	

Sprinkler Tap 205-211

St. ~~Pl.~~
Ave. No. 139


Glen

Name of Owner

Boston Store Co 6" Tap

Labor and Mat'l. Report Dec 18 1925

Woolworth Bldg.

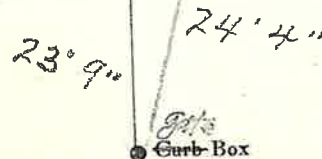

12" Main Elev. of Main at tap 4 1/2'

Gate at • Gate at
This gate shut off and
line capped in Bldg.

• Curb Box

This is now part of
New Woolworth store
was Lerner's Dress shop
before fire

LABOR AND MATERIALS

Copper } Connection Mueller M.J. \$
 Lead }
 1 Curb } Cock } 12" X 6" \$
 } Valve }
 } T. S. & V. }
 1 Service box } Short 3 1/2 x 4 1/2 }
 Old returned } Long 4 1/2 x 5 1/2 }
 } Buff or Rdway } \$
 10 Ft. 4 in. } Copper } Pipe at \$
 } G. I. }
 } C. I. } " S.E.B.
 1 Red'd. 6" in. at X 4" \$
 1 Red'd. 4" to 3" in. at S.E.B. \$
 1 Bushings }
 Red'g } Coupl'gs to in. at \$
 Inc'g }
 Union in. at \$
 Meter in. at \$
 2 Lead Joints at 4" \$
 Compound Joints at \$
 4 Maintenance Foreman 1.937 \$
 Hrs. Water Maint. Man-1 at \$
 2 Hrs. Water Maint. Man-2 at 1.613 \$
 11 Hrs. Garage Foreman at 2.033 \$
 10 Hrs. Labor at 1.481 \$
 23 Hrs. Compressor at lab. 1.30 \$
 Compensation Ins. at \$5.686 per C. \$
 Trucking \$ 1.50
 Pav't Patch \$
 Tap by Lareau & Co. \$
 11-27-56 \$
 O'head \$
 \$

St. 205-
 Pt. 217
 Ave. No. 217

Glen
 Name of Owner F.W.
Woolworth store.

Labor and Mat'l. Report Nov. 27 19 56

23 22'7"
 ● Curb Box gate

12" Main Elev. of Main at tap 6'
 Gate at ● ● Gate at

● Curb Box

Metered Line

L. M-5C-2-1-54