


LABOR AND MATERIALS

Copper	{	Connection	-----	\$	
Lead	}				
Curb	{	Cock	-----	\$	
		Valve	-----	\$	
		T. S. & V.	-----	\$	
Service Box	{	Short 3 1/2 x 4 1/2	-----	\$	
Old returned		Long 4 1/2 x 5 1/2	-----	\$	
		Buff. or Rdway	-----	\$	
Ft. -----	in.	{			
		Copper	Pipe at -----	\$	
		Galv Iron			
		Cast Iron			
Nipples	-----	in. at	-----	\$	
Bushings	-----	to -----	in. at	-----	\$
Red'g	{	Couplings	-----	\$	
Inc'g		to -----	in. at	-----	\$
Union	-----	in. at	-----	\$	
Meter	-----	in. at	-----	\$	
Lead Joints	-----	at	-----	\$	
Leadite Joints	-----	at	-----	\$	
Hrs. Foreman	-----	at	-----	\$	
Hrs. Chauffeur	-----	at	-----	\$	
Hrs. Tapper	-----	at	-----	\$	
Hrs. Labor	-----	at	-----	\$	
Hrs. Labor	-----	at	-----	\$	
Hrs. Compressor	-----	at	-----	\$	
Compensation Ins.	-----		-----	\$	
Trucking	-----		-----	\$	
Builders Use of Water	-----		-----	\$	
			-----	\$	
			-----	\$	
St.
Pl.
Ave. No. 269

Name of Owner _____

Labor and Mat'l. Report 19 14

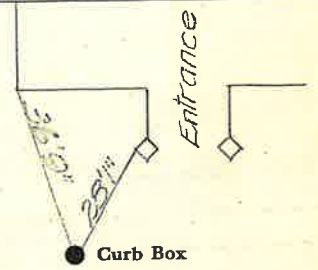

Main Elev. of
Main at tap

Gate at ● ● Gate at

● Curb Box