

LABOR AND MATERIALS

1	Copper Lead	Connection	2"		\$
1	Curb	{ Cock Valve T. S. & V. }	2"	in.	\$
	Service Box	{ Short 3 1/2 x 4 1/2 Long 4 1/2 x 5 1/2 Buff. or Rdway }			\$
	Old returned				
M.H. Motel. 35	Ft. 2				\$
		{ Copper Galv Iron Cast Iron }		Pipe at	\$
	Nipples			in. at	\$
	Bushings			to in. at	\$
	Red'g Inc'g	{ Couplings		to in. at	\$
	Union			in. at	\$
	Meter			in. at	\$
	Lead Joints			at	\$
	Leadite Joints			at	\$
	Hrs. Foreman			at	\$
	Hrs. Chauffeur			at	\$
	Hrs. Tapper			at	\$
	Hrs. Labor			at	\$
	Hrs. Labor			at	\$
	Hrs. Compressor			at	\$
	Compensation Ins.				\$
	Trucking				\$
	Builders Use of Water				\$
					\$
					\$
					\$
					\$


St. 279-280
Ph.
Ave. No. 182

Name of Owner

Hotel Bennett

Labor and Mat'l. Report

19 14

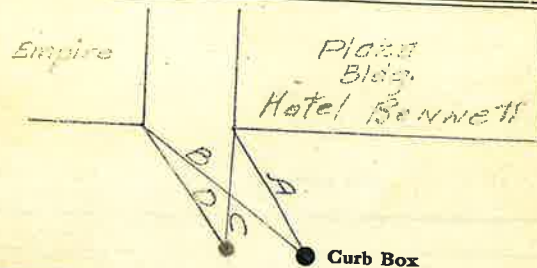

Main South St. Elev. of Main at tap

Gate at ●

● Gate at

● Curb Box

A = 12'9"
B = 23'4"
C = 11'1"
D = 20'11"

Tap on South St

Labor and Materials

1/2" Copper } Connection.....	\$
Lead }	\$
1" Curb { Cock }	in. \$
{ Valve }	in. \$
{ T.S. & V. }	in. \$
Service Box { Short 3" x 4" }	\$
Old returned { Long 4" x 5" }	\$
{ Buff. or Rdway }	\$
35 Ft. 2 in. { Copper } Pipe at.....	\$
{ Galv. Iron }	\$
{ Cast Iron }	\$
Nipples..... in. at.....	\$
Bushings..... to..... in. at.....	\$
1 Red'g } Couplings..... to..... in. at.....	\$
Inc'g }	\$
Union..... in. at.....	\$
Meter..... in. at.....	\$
Lbs. Br. Stone at.....	\$
Lbs. Sand at.....	\$
Bags Cement at.....	\$
Paving Brick { Mack } at.....	\$
{ Red }	\$
{ Asphalt }	\$
Lead Joints at.....	\$
Leadite Joints at.....	\$
Hrs. Foreman at.....	\$
Hrs. Common Labor at.....	\$
Hrs. Common Labor at.....	\$
Hrs. Mason at.....	\$
Hrs. Mason's Helper at.....	\$
Hrs. Compressor at.....	\$
Compensation Ins.....	\$
Trucking.....	\$
Builders' Use of Water.....	\$
Total \$	

182 Glen St. or 1 South St.

Labor and Material Report 19

PLAZA Hotel

Glen St.

Fig. 2

9-74-280 ● Curb Box

Main Elev. of Main at tap

Gate at ● ● Gate at

● Curb Box

Hotel Bennett

Empire

H-12'9"
B-23'4"
C-11'1"
D-20'11"