


LABOR AND MATERIALS

1	Copper Lead	Connection	3/4"	\$
1	Curb	Cock Valve T. S. & V.	3/4" in.	\$
1	Service box	{ Short 3 1/2 x 4 1/2 Long 4 1/2 x 5 1/2 Buff or Rdway }		\$
38' 3/4"	Old returned			
41 Ft.	in.		{ Copper C.I. C.I. }	Pipe at
	Nipples	in. at		\$
	Bushings	to in. at		\$
	Red'g } Inc'g }	Coupl'gs	to in. at	\$
	Union	in. at		\$
	Meter	in. at		\$
	Lead Joints	at		\$
	Compound Joints	at		\$
	Maintenance Foreman			\$
	Hrs. Water Maint. Man-1	at		\$
	Hrs. Water Maint. Man-2	at		\$
	Hrs. Garage Foreman	at		\$
	Hrs. Labor	at		\$
	Hrs. Compressor	at		\$
	Compensation Ins.	at \$ per C		\$
	Trucking			\$
	Pav't Patch			\$
	3/4" Tap by Giggard & Co.			\$
	9-12-68			\$
	O'head			\$
				\$

St. 296
Pl. 304
Ave. No.

Name of Owner Church of Messiah Parish House (New)

Labor and Mat'l. Report 3/4" Tap Sept. 12 1968

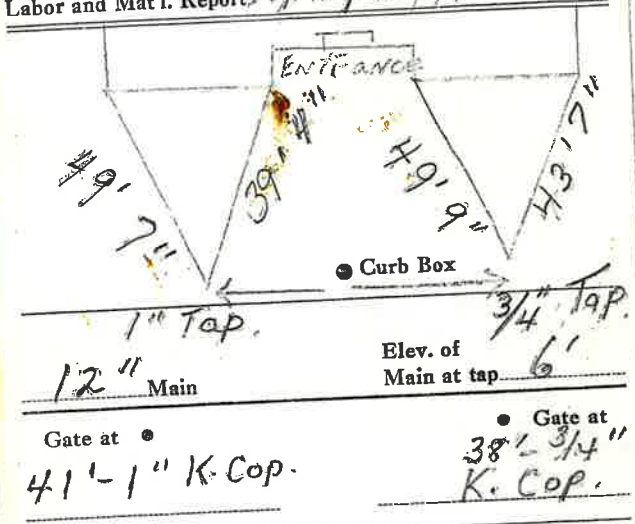

● Curb Box

3/4" - Tap.