

### LABOR AND MATERIALS

Copper	}	Connection			\$	
Lead						
Curb	{	Cock Valve T. S. & V.			\$	
Service Box						
Old returned	}	Short 3/2x4 1/2 Long 4/2x5 1/2 Buff. or Rdway			\$	
Ft.						\$
		}	}	}	}	
		Copper	Galv Iron	Cast Iron	Pipe at	\$
Nipples						\$
Bushings						\$
Red'g	}	Couplings			\$	
Inc'g						
Union						\$
Meter						\$
Lead Joints						\$
Leadite Joints						\$
Hrs. Foreman						\$
Hrs. Chauffeur						\$
Hrs. Tapper						\$
Hrs. Labor						\$
Hrs. Labor						\$
Hrs. Compressor						\$
Compensation Ins.						\$
Trucking						\$
Builders Use of Water						\$
						\$
						\$
						\$
						\$

305-331  
 St. \_\_\_\_\_  
 Pt. \_\_\_\_\_  
 Ave. No. 213

---

Name of Owner  
Spiel

---

Labor and Mat'l. Report 19 44

---

305-331  

Entrance  
Iron Fence  
16' 8"  
11' 10"  
Curb Box

---

		Elev. of
Main	●	Main at tap
Gate at ●		● Gate at
	● Curb Box	

These concretings are shut  
off at Main Sept 24-45

MB

### LABOR AND MATERIALS

Copper	{ Connection	_____	\$	
Lead				
Curb	{ Cock	_____	\$	
	{ Valve	_____	\$	
	{ T. S. & V.	_____	\$	
Service Box	}	Short 3 1/2 x 4 1/2	_____	\$
Old returned		Long 4 1/2 x 5 1/2		
		Buff. or Rdway		
Ft.	}	Copper	_____	\$
in.		Galv Iron		
		Cast Iron		
Nipples	in. at	_____	\$	
Bushings	to in. at	_____	\$	
Red'g	}	_____	\$	
Inc'g				
Union	in. at	_____	\$	
Meter	in. at	_____	\$	
Lead Joints	at	_____	\$	
Leadite Joints	at	_____	\$	
Hrs. Foreman	at	_____	\$	
Hrs. Chauffeur	at	_____	\$	
Hrs. Tapper	at	_____	\$	
Hrs. Labor	at	_____	\$	
Hrs. Labor	at	_____	\$	
Hrs. Compressor	at	_____	\$	
Compensation Ins.		_____	\$	
Trucking		_____	\$	
Builders Use of Water		_____	\$	
		_____	\$	
		_____	\$	
		_____	\$	
		_____	\$	

305-331


St. \_\_\_\_\_  
Pt. \_\_\_\_\_  
Ave. No. 219

Glen

Name of Owner \_\_\_\_\_  
\_\_\_\_\_

Labor and Mat'l. Report 19 14

305-331

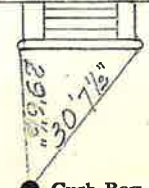

○ ● Curb Box

Main Elev. of Main at tap \_\_\_\_\_

---

Gate at ● ● Gate at

● Curb Box