


LABOR AND MATERIALS

Copper	} Connection	_____	\$ _____
Lead			
Curb	} Cock Valve T. S. & V. }	_____ in.	\$ _____
Service box	{ Short 3½ x 4½ Long 4½ x 5½ Buff or Rdway }	_____	\$ _____
Old returned			
Ft. _____ in.	{ Copper G. I. C. I. }	Pipe at _____	\$ _____
Nipples _____ in.	at _____	\$ _____	
Bushings _____ to _____ in.	at _____	\$ _____	
Red'g } Inc'g }	} Coupl'gs _____ to _____ in.	at _____	\$ _____
Union _____ in.		at _____	\$ _____
Meter _____ in.	at _____	\$ _____	
Lead Joints	at _____	\$ _____	
Compound Joints	at _____	\$ _____	
Maintenance Foreman	_____	\$ _____	
Hrs. Water Maint. Man-1	at _____	\$ _____	
Hrs. Water Maint. Man-2	at _____	\$ _____	
Hrs. Garage Foreman	at _____	\$ _____	
Hrs. Labor- _____	at _____	\$ _____	
Hrs. Compressor	at _____	\$ _____	
Compensation Ins. at \$ _____	per C _____	\$ _____	
Trucking _____		\$ _____	
Pav't Patch _____		\$ _____	
		\$ _____	
		\$ _____	
O'head _____		\$ _____	
		\$ _____	

Sept 10 - 1980

Glen ST St. Pl. Ave. No. 330
 Name of Owner Mobil ST.

Labor and Mat'l. Report 1980

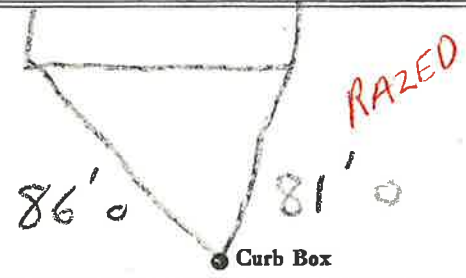

Main Elev. of Main at tap _____
 Gate at • Gate at •
 Curb Box