


Labor and Materials

Copper } Connection.....	\$.....
Lead }	\$.....
Curb { Cock Valve }	\$.....
{ T.S.&V. }	\$.....
Service Box { Short 3½x4½ }	\$.....
Old returned { Long 4½x5½ }	\$.....
{ Buff. or Rdw. }	\$.....
Ft.....in. { Copper } Pipe at	\$.....
{ Galv. Iron }	\$.....
{ Cast Iron }	\$.....
Nipplesin. at	\$.....
Bushingstoin. at.....	\$.....
Red'g } Couplings.....to.....in.at.....	\$.....
Inc'g }	\$.....
Union.....in. at	\$.....
Meter.....in. at	\$.....
Lbs. Br. Stone at	\$.....
Lbs. Sand at	\$.....
Bags Cement at	\$.....
Paving Brick { Mack } at	\$.....
{ Red }	\$.....
{ Asphalt }	\$.....
Lead Joints at	\$.....
Leadite Joints at	\$.....
Hrs. Foreman at	\$.....
Hrs. Common Labor at	\$.....
Hrs. Common Labor at	\$.....
Hrs. Mason at	\$.....
Hrs. Masons Helper at	\$.....
Hrs. Compressor at	\$.....
Compensation Ins	\$.....
Trucking	\$.....
Builders Use of Water	\$.....
Total \$.....	

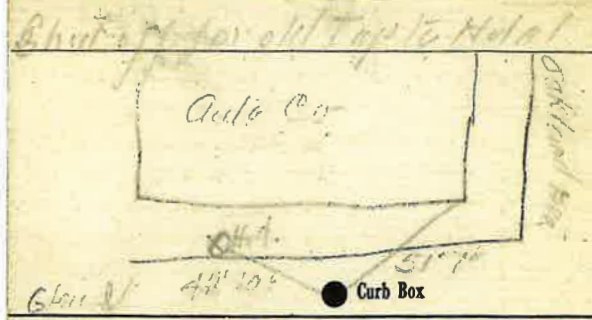

Main Elev. of Main at tap

Gate at ● ● Gate at

● Curb Box

Shut off Nov 10 34

by [signature]

[signature]


shut off for old tap to hotel

shut off Nov 1934

Labor and Materials

.....Copper } Connection.....\$.....
.....Lead }\$.....
.....Curb { Cock Valve }in.....\$.....
.....T.S.&V. }\$.....
.....Service Box { Short 3½x4½ }\$.....
.....Old returned { Long 4½x5½ }\$.....
.....Buff. or Rdway }\$.....
.....Ft.....in. { Copper Galv. Iron } Pipe at\$.....
.....Cast Iron }\$.....
.....Nipplesin. at\$.....
.....Bushingstoin. at.....\$.....
.....Red'g } Couplings.....to.....in.at.....\$.....
.....Inc'g }\$.....
.....Union.....in. at\$.....
.....Meter.....in. at\$.....
.....Lbs. Br. Stone at\$.....
.....Lbs. Sand at\$.....
.....Bags Cement at\$.....
.....Paving Brick { Mack Red Asphalt } at\$.....
.....Lead Joints at\$.....
.....Leadite Joints at\$.....
.....Hrs. Foreman at\$.....
.....Hrs. Common Labor at\$.....
.....Hrs. Common Labor at\$.....
.....Hrs. Mason at\$.....
.....Hrs. Masons Helper at\$.....
.....Hrs. Compressor at\$.....
.....Compensation Ins\$.....
.....Trucking\$.....
.....Builders Use of Water\$.....
Total \$.....	

Shut off for old Tap to Meter

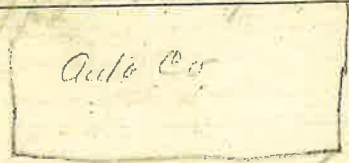

6/11/10 4/10/10

Main	Elev. of Main at tap
Gate at ●	● Gate at
● Curb Box	

Shut off Nov 11 39

by [Signature]

[Signature]