


## LABOR AND MATERIALS

Copper	} Connection	_____	\$ _____	
Lead				
Curb	} Cock Valve T. S. & V.	_____ in.	\$ _____	
Service Box		} Short 3 1/2 x 4 1/2 Long 4 1/2 x 5 1/2 Buff. or Rdway	_____	\$ _____
Old returned				
Ft. _____ in.	} Copper Galv Iron Cast Iron		Pipe at _____	\$ _____
Nipples		_____ in. at _____	\$ _____	
Bushings		_____ to _____ in. at _____	\$ _____	
Red'g Inc'g	} Couplings	_____ to _____ in. at _____	\$ _____	
Union		_____ in. at _____	\$ _____	
Meter	_____ in. at _____	\$ _____		
Lead Joints	at _____	\$ _____		
Leadite Joints	at _____	\$ _____		
Hrs. Foreman	at _____	\$ _____		
Hrs. Chauffeur	at _____	\$ _____		
Hrs. Tapper	at _____	\$ _____		
Hrs. Labor	at _____	\$ _____		
Hrs. Labor	at _____	\$ _____		
Hrs. Compressor	at _____	\$ _____		
Compensation Ins.	_____	\$ _____		
Trucking	_____	\$ _____		
Builders Use of Water	_____	\$ _____		
		\$ _____		
		\$ _____		
St. \_\_\_\_\_  
Pl. \_\_\_\_\_  
Ave. No. 326

Name of Owner \_\_\_\_\_  
\_\_\_\_\_

Labor and Mat'l. Report \_\_\_\_\_ 1914

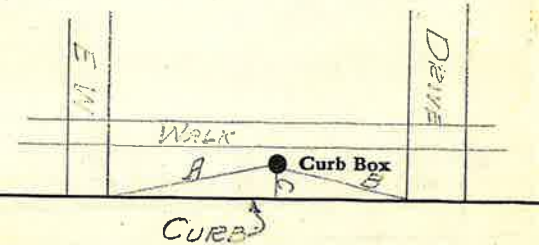

Main Elev. of  
Main at tap \_\_\_\_\_

---

Gate at ● ● Gate at

● Curb Box

A = 13'7"  
B = 8'9"  
C = 6'8"