


LABOR AND MATERIALS

| | | | | |
|------------------------------|-------------------------------|-------------|--|----------------|
| Copper | } Connection | | \$ | |
| Lead | | | | |
| Curb | } Cock Valve T. S. & V. | in. | \$ | |
| | | Service box | } Short 3 1/2 x 4 1/2 Long 4 1/2 x 5 1/2 Buff or Rdway | \$ |
| | | | | |
| Ft. | in. | } Pipe at | \$ | |
| | | | | Copper |
| | | | | G. I. C. I. |
| Nipples | in. | at | \$ | |
| Bushings | to | in. | at | |
| Red'g | } Coupl'gs | to | in. | at |
| Inc'g | | | | |
| Union | in. | at | \$ | |
| Meter | in. | at | \$ | |
| Lead Joints | at | | \$ | |
| Compound Joints | at | | \$ | |
| Maintenance Foreman | | | \$ | |
| Hrs. Water Maint. Man-1 | at | | \$ | |
| Hrs. Water Maint. Man-2 | at | | \$ | |
| Hrs. Garage Foreman | at | | \$ | |
| Hrs. Labor | at | | \$ | |
| Hrs. Compressor | at | | \$ | |
| Compensation Ins. | at \$ | per C | \$ | |
| Trucking | | | \$ | |
| Pay't Patch | | | \$ | |
| <i>Measured in by</i> | | | | |
| <i>Lorenz & Wadleigh</i> | | | | |
| O'head | | | \$ | |

Glen St.
Pl.
Ave. No.

Name of Owner
City of Glens Falls

Labor and Mat'l. Report 19

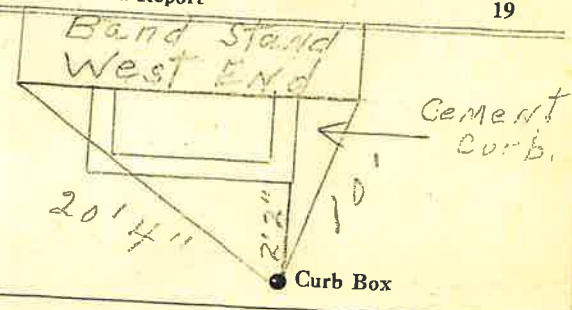

Main Elev. of
Main at tap

Gate at ● ● Gate at

Measurements ● Curb Box

*For Hose Connection
in City Park Near
Band Stand.*