

LABOR AND MATERIALS

1	Copper } Connection <u>3/4</u>	\$
1	Curb } Cock } <u>ORISEAL</u> in.	\$
	} Valve } <u>in.</u>	
	} T.C. & V. }	
1	Service box { Short <u>3-1/2 x 4-1/2</u>	\$
	Old returned { Long <u>4-1/2 x 5-1/2</u> }	
31	Ft. <u>3/4</u> in. { Copper } Pipe at	\$
	Nipples _____ in. at _____	\$
	Bushings _____ to _____ in. at _____	\$
	Red'g _____	
	Inc'g _____	
	Union _____ in. at _____	\$
	Meter _____ in. at _____	\$
	Compound Joints at _____	\$
	Maintenance Foreman _____	\$
	Hrs. Water Maint. Man - 1 at _____	\$
	Hrs. Water Maint. Man - 2 at _____	\$
	Hrs. Garage Foreman _____ at _____	\$
	Hrs. Labor _____ at _____	\$
	Hrs. Compressor at _____	\$
	Trucking _____	\$
	Pav't Patch _____	\$
	_____	\$
	_____	\$
CHANGED TO COPPER FROM
TUBELOY ON 7-12-65


GLEN

St. No. 356-366

Name of Owner _____

Labor and Mat'l. Report 19 70, JAN.

B
A
C
O
N
S
T.

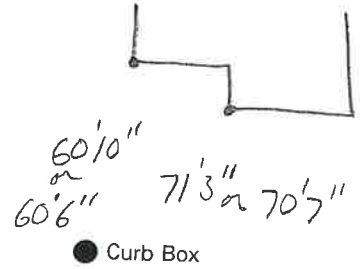

6" Main

Elev. of Main at tap 5'

Gate at ●

GLEN ST.

● Gate at

N →

● Curb Box