

LABOR AND MATERIALS

Copper } Connection 10x8 T.S.  
 Lead }  
 Curb } Cook Valve } 8 in. \$  
       } T.S. & V. }  
 Service box { Short 3 1/2 x 4 1/2 }  
 Old returned { Long 4 1/2 x 5 1/2 } \$  
               { Buff or Rdway }  
 8 Ft. in. { Copper } Pipe at 8" \$  
            { C.I. }  
 Nipples in. at \$  
 Bushings to in. at \$  
 Red'g }  
 Inc'g } Coupl'gs. to in. at \$  
 Union in. at \$  
 Meter in. at \$  
 Lead Joints at \$  
 Compound Joints at \$  
 Maintenance Foreman \$  
 Hrs. Water Maint. Man-1 at \$  
 Hrs. Water Maint. Man-2 at \$  
 Hrs. Garage Foreman at \$  
 Hrs. Labor at \$  
 Hrs. Compressor at \$  
 Compensation Ins. at \$ per C \$  
 Trucking \$  
 Pav't Patch \$  
 O'head \$

St. Elon  
 Pt. 41-77  
 Ave. No. 41-77

Name of Owner  
City of Elons Falls

Labor and Mat'l. Report 1970

10" Main Elev. of Main at tap 4 1/2'

Gate at ● Gate at ●

8' to MAIN

● Curb Box

### LABOR AND MATERIALS

Copper	}	Connection		\$	
Lead					
Curb	}	Cock	} in.		
		Valve			
		T. S. & V.			
Service box	}	Short 3½ x 4½			
Old returned		Long 4½ x 5½			
		Buff or Rdway			
Ft. _____ in.	}	Copper	} Pipe at		
		G. I.			
		C. I.			
Nipples	in. at				
Bushings	to in. at				
Red'g	}	Coupl'gs	to in. at		
Inc'g					
Union	in. at				
Meter	in. at				
Lead Joints	at				
Compound Joints	at				
Maintenance Foreman					
Hrs. Water Maint. Man—1	at				
Hrs. Water Maint. Man—2	at				
Hrs. Garage Foreman	at				
Hrs. Labor—	at				
Hrs. Compressor	at				
Compensation Ins. at \$	per C				
Trucking					
Pav't Patch					
O'head					


St.  
~~Pl.~~  
Ave. No. \_\_\_\_\_

GLEN

Name of Owner \_\_\_\_\_

GLEN FALL CIVIC CENTER

Labor and Mat'l. Report NOV. 19 81

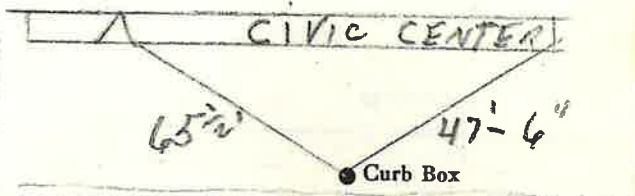

GLEN ST GATE 1007  
BY ROAD

6" Main      Elev. of Main at tap \_\_\_\_\_

Gate at ●      ● Gate at

● Curb Box