


Labor and Materials

1	Copper } Connection. 1"		\$26.9
	Lead }		
1	Curb { Cock Valve F.S. & V. } 1" in.		\$1.74
1	Service Box { Short 3 1/2 x 4 1/2 Old returned { Long 4 1/2 x 5 1/2 Buff. or Rdway }		\$1.40
	Ft. N.O. in. { Copper Galv. Iron } Pipe at. N.O.		\$
	Cast Iron }		
	Nipples..... in. at.....		\$
	Bushings..... to..... in. at.....		\$
	Red'g } Couplings..... to..... in. at.....		\$
	Inc'g }		
	Union..... in. at.....		\$
	Meter..... in. at.....		\$
	Lbs Br. Stone at.....		\$
	Lbs. Sand at.....		\$
	Bags Cement at.....		\$
	Paving Brick { Mack Red } at.....		\$
	Asphalt }		
	Lead Joints at.....		\$
	Leadite Joints at.....		\$
6	Hrs. Foreman at... 32.5-		\$ 3.75
7	Hrs. Common Labor at... 5.0		\$ 3.50
11	Hrs. Common Labor at... 40.50		\$ 4.46
	Hrs. Mason at.....		\$
	Hrs. Mason's Helper at.....		\$
	Hrs. Compressor at.....		\$
	Compensation Ins.....		\$.31
	Trucking.....		\$ 1.00
	Builders' Use of Water.....		\$
Total			\$ 18.87

Labor and Material Report

19

26-70 369-389
1" Top at 233 Glen St

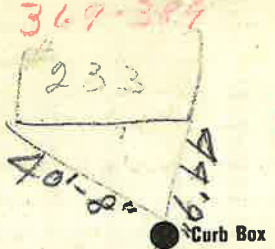

12 Main

Elev. of Main at tap 3.5'

Gate at ●

● Gate at

● Curb Box

Pavement