

### LABOR AND MATERIALS


1	Copper	Connection	$\frac{3}{4}$		\$
	Lead	Cock			
		Valve	$\frac{3}{4}$ in.		\$
	1	T.S. & V.			
	Service box	Short $3\frac{1}{2} \times 4\frac{1}{2}$			
	Old returned	Long $4\frac{1}{2} \times 5\frac{1}{2}$			
		Buff or Rdway			\$
	14 Ft.	Copper			
	$\frac{3}{4}$ in.	C.I.			
		C.I.			
		Pipe at			\$
	Nipples	in. at			\$
	Bushings	to in. at			\$
	Red'g				
	Inc'g	Coupl'gs to in. at			\$
	Union	in. at			\$
	Meter	in. at			\$
	Lead Joints at				\$
	Compound Joints at				\$
	Maintenance Foreman				\$
	Hrs. Water Maint. Man-1 at				\$
	Hrs. Water Maint. Man-2 at				\$
	Hrs. Garage Foreman at				\$
	Hrs. Labor at				\$
	Hrs. Compressor at				\$
	Compensation Ins. at \$	per C			\$
	Trucking				\$
	Pav't Patch				\$
	<i>Tap by Beecher &amp; Co</i>				
	<i>Sept 22, 1978</i>				
	O'head				\$
					\$

Glen

St.  
Pl.  
Ave. No. 391

Name of Owner  
*William Canale*

Labor and Mat'l. Report *Sept. 22, 1978*

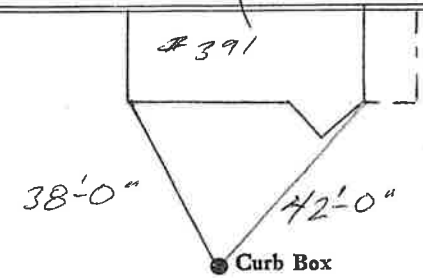

*12"* Main Elev. of Main at tap *5'*

Gate at ● ● Gate at

● Curb Box