
LABOR AND MATER	_
Copper Connection 3/4	\$
Curb Cock Velve T.S&-V. 3/4 in	
Service box Short 3-1/2 x 4-1/2 Cld returned Short 3-1/2 x 5-1/2	
Ft. $\frac{3/4}{4}$ in. $\left\{\begin{array}{c} \frac{60pper}{G.I.} \\ \frac{G.I.}{G-4} \end{array}\right\}$ Pipe at	\$
Nipples in. at	
Bushings to in. at	\$
Red'g	
Inc'g	
Union in. at	\$
Meter in. at	\$
	\$
Compound Joints at	\$
Maintenance Foreman	\$
Hrs. Water Maint. Man - 1 at	\$
Hrs. Water Maint. Man - 2 at	\$
Hrs. Garage Foreman at	\$
Hrs. Labor at	
Hrs. Compressor at	\$
Trucking	
Pav't Patch	
	\$

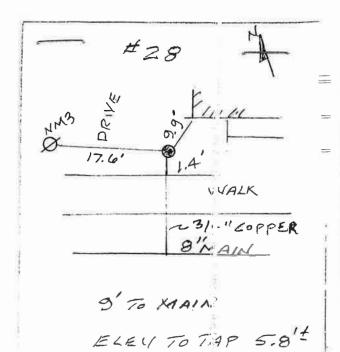

TAX ID # 302.20-6-32

SEPT 2006