


LABOR AND MATERIALS

1	Copper	Connection		\$
1	Curb	Cock Valve		\$
		IS-8-4	in.	\$
1	Service box	Short 3-1/2 x 4-1/2		\$
	Old returned	Long 4-1/2 x 5-1/2		\$
11	Ft.	3/4 in. Copper	Pipe at	\$
		Nipples	in. at	\$
		Bushings	to in. at	\$
		Red'g		
		Inc'g		
		Union	in. at	\$
		Meter	in. at	\$
				\$
		Compound Joints at		\$
		Maintenance Foreman		\$
		Hrs. Water Maint. Man - 1 at		\$
		Hrs. Water Maint. Man - 2 at		\$
		Hrs. Garage Foreman	at	\$
		Hrs. Labor	at	\$
		Hrs. Compressor at		\$
				\$
		Trucking		\$
		Pav't Patch		\$
				\$
				\$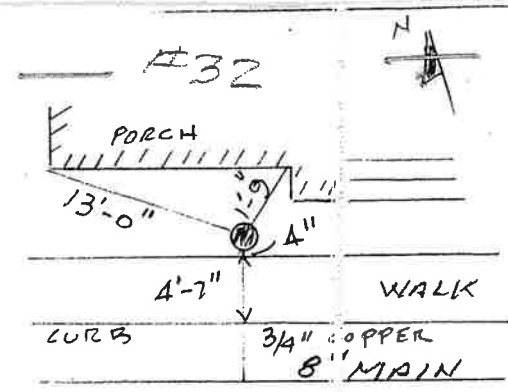
8.5' TO MAIN
ELEV TO TAP 5.5'

SEPT 2006