

LABOR AND MATERIALS


1	Copper } Connection	\$	
1	Lead } Cock	\$	
	Curb } Valve	\$	
			in.
1	Service box { Short 3-1/2 x 4-1/2 }	\$	
	Old returned { Long 4-1/2 x 5-1/2 }	\$	
10	Ft. in. { Copper } Pipe at	\$	
	Nipples	\$	
	in. at	\$	
	Bushings	\$	
	to in. at	\$	
	Red'g	\$	
	Inc'g	\$	
	Union	\$	
	in. at	\$	
	Meter	\$	
	in. at	\$	
		\$	
	Compound Joints at	\$	
	Maintenance Foreman	\$	
	Hrs. Water Maint. Man - 1 at	\$	
	Hrs. Water Maint. Man - 2 at	\$	
	Hrs. Garage Foreman at	\$	
	Hrs. Labor at	\$	
	Hrs. Compressor at	\$	
		\$	
	Trucking	\$	
	Pav't Patch	\$	
		\$	
		\$	
GOODWIN

Ave. No. 38

Name of Owner

Labor and Mat'l. Report 1930, JUNE 11

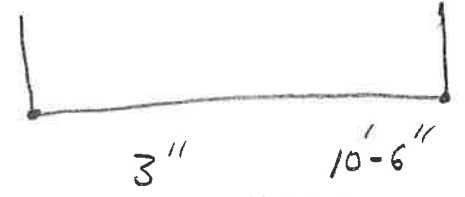

● Curb Box

4" Main

Elev. of Main at tap 5'

Gate at ●

● Gate at

● Curb Box