

LABOR AND MATERIALS


1 Copper } Connection $\frac{3}{4}$ \$ _____
 1 Curb } Cock } $\frac{3}{4}$ in. \$ _____
 1 Service box } ~~Short 3-1/2 x 4-1/2~~ } \$ _____
 Old returned } Long 4-1/2 x 5-1/2 }
 20 Ft. $\frac{3}{4}$ in. } Copper } Pipe at \$ _____
 _____ Nipples _____ in. at \$ _____
 _____ Bushings _____ to _____ in. at \$ _____
 _____ Red'g _____
 _____ Inc'g _____
 _____ Union _____ in. at \$ _____
 _____ Meter _____ in. at \$ _____
 _____ \$ _____
 _____ Compound Joints at \$ _____
 _____ Maintenance Foreman \$ _____
 _____ Hrs. Water Maint. Man - 1 at \$ _____
 _____ Hrs. Water Maint. Man - 2 at \$ _____
 _____ Hrs. Garage Foreman _____ at \$ _____
 _____ Hrs. Labor _____ at \$ _____
 _____ Hrs. Compressor at \$ _____
 _____ \$ _____
 _____ Trucking \$ _____
 _____ Pav't Patch \$ _____
 _____ \$ _____
 _____ \$ _____
 _____ \$ _____
 _____ \$ _____

GRAND

St. No. 4

Name of Owner

Labor and Mat'l. Report 1932, OCT. 3

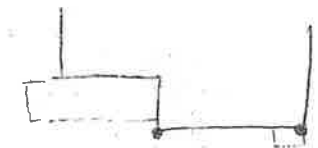

17' 19-8"

● Curb Box

4" Main (GALV.)

Elev. of Main at tap 5'

Gate at ●

● Gate at

● Curb Box

OLD TAP TO BE DUG UP