

LABOR AND MATERIALS

1	Copper	Lead	Connection	$\frac{3}{4}$			\$ 2.94	
1	Curb	Clock Valve	P.S. & V.	$\frac{3}{4}$	in.		\$ 3.71	
	Service box	Old returned	Short $3\frac{1}{2} \times 4\frac{1}{2}$ Long $4\frac{1}{2} \times 5\frac{1}{2}$ Buff or Rdway	9ans.			\$ 1.00	
8	Ft.	$\frac{3}{4}$	in.	Copper Galv Iron Cast Iron	Pipe at	30	\$ 2.40	
	Nipples		in.	at			\$	
	Bushings		to		in.	at	\$	
	Red'g Inc'g	Couplings		to		in.	at	\$
	Union		in.	at			\$	
	Meter		in.	at			\$	
	Lead Joints			at			\$	
	Compound Joints			at			\$	
	Hrs. Foreman			at			\$	
6	Hrs. Checker			at	WMM	2 91	\$ 5.46	
	Hrs. Tapper			at			\$	
1.2	Hrs. Labor			at		80	\$ 9.60	
	Hrs. Labor			at			\$	
1	Hrs. Compressor			at		1.20	\$ 1.20	
	Compensation Ins.						\$ 33	
	Trucking						\$ 1.00	
	Builders Use of Water		Patch				\$ 6.70	
	1000 yd. marshals						\$	
							\$	
							\$	
							\$	
							\$ 33.34	

28

St.
Pl.
Ave. No. 15


Grand

Name of Owner

Kennedy

Labor and Mat'l. Report

Apr 16 1948

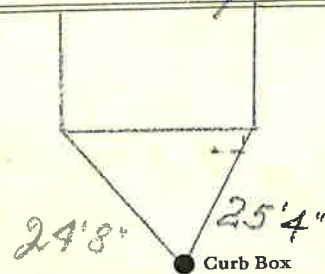

4 Gal Main

Elev. of Main at tap $4\frac{1}{2}$

Gate at ● Gate at ●

● Curb Box