

LABOR AND MATERIALS

1 Copper } Connection $\frac{3}{4}$ \$ 1.59
 Lead }
 1 Curb } Clock Valve } $\frac{3}{4}$ in. \$ 2.74
 (F. S. & V.) }
 1 Service box } Short $3\frac{1}{2} \times 4\frac{1}{2}$ } \$ 1.82
 Old returned } Long $4\frac{1}{2} \times 5\frac{1}{2}$ }
 Buffer Rdway }
 6 Ft. $\frac{3}{4}$ in. } Copper } Pipe at 19 \$ 1.14
 Galv. Iron }
 Cast Iron }
 Nipples in. at \$
 Bushings to in. at \$
 Red'g } Couplings..... to in. at \$
 Inc'g }
 Union in. at \$
 Meter in. at \$
 Lead Joints at \$
 Compound Joints at \$
 Hrs. Foreman at \$
 Hrs. Chauffeur at \$
 Hrs. Tapper at \$
 Hrs. Labor at \$
 Hrs. Labor at \$
 Hrs. Compressor at \$
 Compensation Ins. \$
 Trucking \$
 Builders Use of Water. \$
 Top by Maguire \$
 old top dug up at Skul \$
 off bit valve (Paid for) \$
 \$

745

31 ✓


Grand

St.
 Pl.
 Ave. No. 25

Name of Owner

Regan

Labor and Mat'l. Report Nov 14 1945

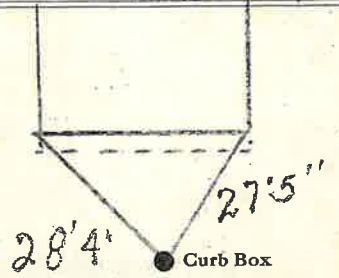

4 Main

Elev. of Main at tap 5

Gate at ●

● Gate at

● Curb Box

- REPAIRED LEAK 10-12-00