

LABOR AND MATERIALS


1	Copper } Connection $\frac{3}{4}$	\$
1	Curb } Cock } $\frac{3}{4}$ in.	\$
1	Service box } { Short 3-1/2 x 4-1/2 } Old returned } { Long 1-1/2 x 5-1/2 }	\$
27	Ft. $\frac{3}{4}$ in. } { Copper } Pipe at	\$
	Nipples _____ in. at	\$
	Bushings _____ to _____ in. at	\$
	Red'g _____	
	Inc'g _____	
	Union _____ in. at	\$
	Meter _____ in. at	\$
	Compound Joints at	\$
	Maintenance Foreman _____	\$
	Hrs. Water Maint. Man - 1 at	\$
	Hrs. Water Maint. Man - 2 at	\$
	Hrs. Garage Foreman _____ at	\$
	Hrs. Labor _____ at	\$
	Hrs. Compressor at	\$
	Trucking _____	\$
	Pav't Patch _____	\$
		\$
		\$
GRAND

St. Ave. No. 32

Name of Owner

Labor and Mat'l. Report 19 30, Oct. 21

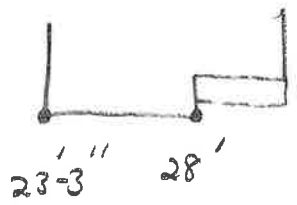

● Curb Box

4" Main (G.A.V.)

Elev. of Main at tap 4'

Gate at ●

● Gate at

● Curb Box

OLD TAP DISCONNECTED