


Labor and Materials

1	Copper } Connection <i>3/4</i>	\$ 3.20
	Lead }	
1	Curb { Cock } <i>3/4</i> in.	\$ 1.00
	{ Valve }	
	{ T.S. & V. }	
1	Service Box { Short $3\frac{1}{2} \times 4\frac{1}{2}$ }	\$ 1.30
	Old returned { Long $4\frac{1}{2} \times 5\frac{1}{2}$ } { Buff. or Rdway }	
25	Ft. <i>3/4</i> in. { Copper } Pipe at.....	\$ 5.50
	{ Galv. Iron }	
	{ Cast Iron }	
	Nipples..... in. at.....	\$
	Bushings..... to..... in. at.....	\$
1	Red'g } Couplings. <i>100000</i> in. at.....	\$ 1.15
	Inc'g }	
	Union..... in. at.....	\$
	Meter..... in. at.....	\$
	Lbs. Br. Stone at.....	\$
	Lbs. Sand at.....	\$
	Bags Cement at.....	\$
	Paving Brick { Mack } at.....	\$
	{ Red }	
	{ Asphalt }	
	Lead Joints at.....	\$
	Leadite Joints at.....	\$
28	Hrs. Foreman at..... <i>6.25</i>	\$ 14.00
15	Hrs. Common Labor at..... <i>5.0</i>	\$ 7.50
8	Hrs. Common Labor at..... <i>4.25</i>	\$ 3.25
	Hrs. Mason at.....	\$
	Hrs. Mason's Helper at.....	\$
5	Hrs. Compressor at.....	\$ 1.00
	Compensation Ins.....	\$ 1.00
yes	Trucking.....	\$ 1.50
no	Builders' Use of Water.....	\$
	<i>Rock.</i>	
	Total \$ <i>57.40</i>	

Labor and Material Report

49 Apr 27 1927

Tap at 38' main at

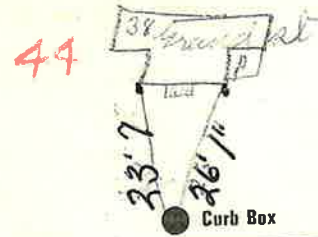

49' Main

Elev. of Main at tap *4ft*

Gate at ●

● Gate at

● Curb Box

*Old shut off
25' to main*