


Labor and Materials

Copper	} Connection.....	2	\$7.60	
Lead				
Curb	} Cock Valve T.S.&V. } .....	1	\$2.27	
		in		
Service Box	} Short 3 1/2 x 4 1/2 } .....	1	\$1.38	
		Long 4 1/2 x 5 1/2 } .....		
Old returned	Buff. or Rdwe.			
23 Ft.	in	} Copper Galv. Iron Cast Iron } Pipe at .....	2	\$4.14
	in. at .....			
Nipples	in. at .....		\$	
Bushings	to .....	in. at .....	\$	
Red'g Inc'g	} Couplings.....	to .....	in. at .....	
Union		in. at .....	\$	
Meter	in. at .....	\$		
Lbs. Br. Stone	at .....	\$		
Lbs. Sand	at .....	\$		
Bags Cement	at .....	\$		
Paving Brick	} Mack Red Asphalt } at .....		\$	
			\$	
Lead Joints	at .....	\$		
Leadite Joints	at .....	\$		
8 Hrs.	Foreman at .....		\$5.00	
16 Hrs.	Common Labor at .....		\$7.20	
Hrs.	Common Labor at .....		\$	
Hrs.	Mason at .....		\$	
Hrs.	Masons Helper at .....		\$	
Hrs.	Compressor at .....		\$	
Compensation Ins	.....		\$1.37	
Trucking	.....		\$1.00	
Builders Use of Water	.....		\$5.00	
Total \$			2896	

Labor and Material Report

32-52  
5  
46  
29 1931

40 Grand St

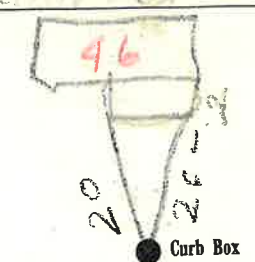

4 1/2' Main  
Elev. of Main at tap 4 1/2'  
Gate at ● Gate at ●

● Curb Box  
old top shut off  
at Main  
1/10