

LABOR AND MATERIALS


1	Copper Lead	Connection	3/4"	\$
1	Curb	Cock Valve T.O. & W.	3/4" in.	\$
1	Service box Old returned	{ Short 3-1/2 x 4-1/2 Long 4-1/2 x 5-1/2 }		\$
27	Ft.	3/4 in. { Copper Pipes }	Pipe at	\$
	Nipples		in. at	\$
	Bushings		to in. at	\$
	Red'g			\$
	Inc'g			\$
	Union		in. at	\$
	Meter		in. at	\$
	Compound Joints	at		\$
	Maintenance Foreman			\$
	Hrs. Water Maint. Man - 1	at		\$
	Hrs. Water Maint. Man - 2	at		\$
	Hrs. Garage Foreman	at		\$
	Hrs. Labor	at		\$
	Hrs. Compressor	at		\$
	Trucking			\$
	Pav't Patch			\$
				\$
				\$
GRAND

St. Ave. No. 12

Name of Owner

Labor and Mat'l. Report 1936, Nov. 12

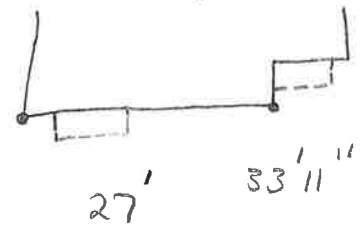

● Curb Box

4" Main

Elev. of Main at tap 4 1/2'

Gate at ●

● Gate at

● Curb Box

OLD TAP SHUT OFF