


LABOR AND MATERIALS

1	Copper Lead	} Connection	3/4"	\$
1	Curb } Cock } Valve } T.C. & V. }			
1	Service box Old returned	{	Short 3-1/2 x 4-1/2 Long 4-1/2 x 5-1/2	\$
12	Ft. 3/4" in. } Copper } C.I. } C.I. }			
	Nipples		in. at	\$
	Bushings		to _____ in. at	\$
	Red'g			\$
	Inc'g			\$
	Union		in. at	\$
	Meter		in. at	\$
				\$
	Compound Joints at			\$
	Maintenance Foreman			\$
	Hrs. Water Maint. Man - 1 at			\$
	Hrs. Water Maint. Man - 2 at			\$
	Hrs. Garage Foreman		at	\$
	Hrs. Labor		at	\$
	Hrs. Compressor at			\$
				\$
	Trucking			\$
	Pav't Patch			\$
				\$
				\$
				\$
				\$

St. GRANT
Ave. No. 15

Name of Owner _____

Labor and Mat'l. Report 19 35, OCT. 3

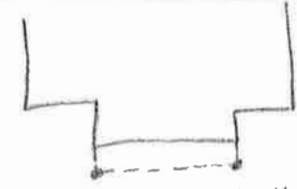

31'6" 32'7"
● Curb Box

4" Main Elev. of Main at tap 4 1/2'

Gate at ● Gate at ●

TAX ID # 302.15-14-24

● Curb Box

OLD TAP SHUT OFF AT MAIN