

LABOR AND MATERIALS


1	Copper lead } Connection	3/4	\$
1	Curb } Cock Valve T.S. & V. }	3/4 in.	\$
1	Service box } Old returned { Short 3-1/2 x 4-1/2 - Long 4-1/2 x 5-1/2 }		\$
9	Ft. 3/4 in. { Copper C.T. C.T. }	Pipe at	\$
	Nipples	in. at	\$
	Bushings	to in. at	\$
	Red'g		
	Inc'g		
	Union	in. at	\$
	Meter	in. at	\$
	Compound Joints at		\$
	Maintenance Foreman		\$
	Hrs. Water Maint. Man - 1 at		\$
	Hrs. Water Maint. Man - 2 at		\$
	Hrs. Garage Foreman	at	\$
	Hrs. Labor	at	\$
	Hrs. Compressor at		\$
	Trucking		\$
	Pav't Patch		\$
			\$
			\$
GRANT

St. Pt. Ave. No. 17

Name of Owner

Labor and Mat'l. Report 19 26, NOV. 30

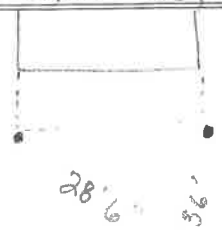

● Curb Box

4" Main

Elev. of Main at tap 4'

Gate at ●

● Gate at

9' to MAIN

● Curb Box