


LABOR AND MATERIALS

1	Copper Lead	Connection	3/4	\$	
1	Curb	Cock Valve T.S. & V.	3/4 in.	\$	
1	Service box Old returned	{ Short 3-1/2 x 4-1/2 Long 4-1/2 x 5-1/2 }		\$	
10	Ft. 3/4 in.	{ Copper Gal. S.W.	} Pipe at	\$	
	Nipples		in. at	\$	
	Bushings		to in. at	\$	
	Red'g				
	Inc'g				
	Union		in. at	\$	
	Meter		in. at	\$	
				\$	
	Compound Joints		at	\$	
	Maintenance Foreman			\$	
	Hrs. Water Maint. Man - 1		at	\$	
	Hrs. Water Maint. Man - 2		at	\$	
	Hrs. Garage Foreman		at	\$	
	Hrs. Labor		at	\$	
	Hrs. Compressor		at	\$	
				\$	
	Trucking			\$	
	Pav't Patch			\$	
				\$	
				\$	
GRANT St. Pt. Ave. No. 19

Name of Owner

Labor and Mat'l. Report 19 31 Oct 13

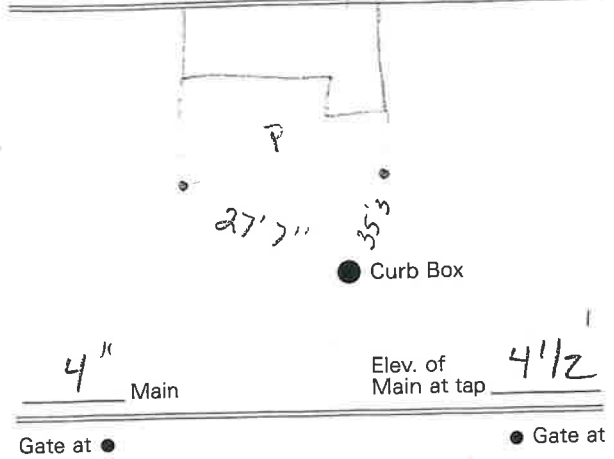

OLD TAP DISCONNECTED