

### LABOR AND MATERIALS


1	Copper } Connection	3/4"	\$
	Lead }		
1	Curb } Cock valve	3/4" in.	\$
	T.S. & V. }		
1	Service box { Short 3-1/2 x 4-1/2		\$
	Old returned { Long 4-1/2 x 5-1/2		
9	Ft. 3/4 in. { Copper		\$
	Gal. }		
	Gal. }		
	Nipples	in. at	\$
	Bushings	to in. at	\$
	Red'g		
	Inc'g		
	Union	in. at	\$
	Meter	in. at	\$
			\$
	Compound Joints at		\$
	Maintenance Foreman		\$
	Hrs. Water Maint. Man - 1 at		\$
	Hrs. Water Maint. Man - 2 at		\$
	Hrs. Garage Foreman	at	\$
	Hrs. Labor	at	\$
	Hrs. Compressor at		\$
			\$
	Trucking		\$
	Pav't Patch		\$
			\$
			\$
GRANT

St. Ave. No. 23

Name of Owner TAX ID # 302.15-14-20

Labor and Mat'l. Report 1934, NOV. 5

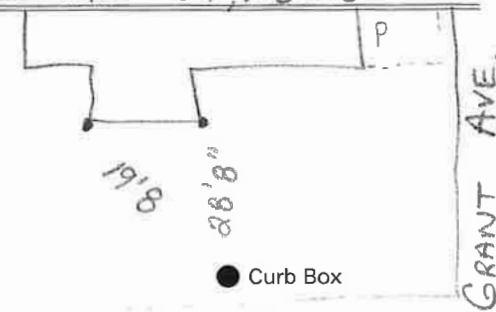

DAVIS St. 4 Main Elev. of Main at tap 5 1/2

Gate at ● Gate at ●

● Curb Box

OLD TAP SHUT OFF